


SEPTIC SYSTEM INSTALLATION CERTIFICATION AND "AS-BUILT"

OWNER'S NAME: JEFF & MICHELLE TATUM 263 S. Harrington Rd.  
Coupeville, WA 98239

FILE # 198-97 PARCEL # ST350-00-0A008-0 Lawana Beach

ACCURATE PLOT PLAN DRAWN TO SCALE INCLUDING, BUT NOT LIMITED TO, THE FOLLOWING:

- Location of building(s) (i.e., distance from roads, etc.)
- Size of building(s)
- Location of septic tank and pump or siphon chamber(s), if applicable (i.e., distance from building, etc.)
- Location of drainfields (i.e., distance from house, septic tank, property lines, wells, banks, water of the State, french drain(s), roads, driveways, large trees, etc.)

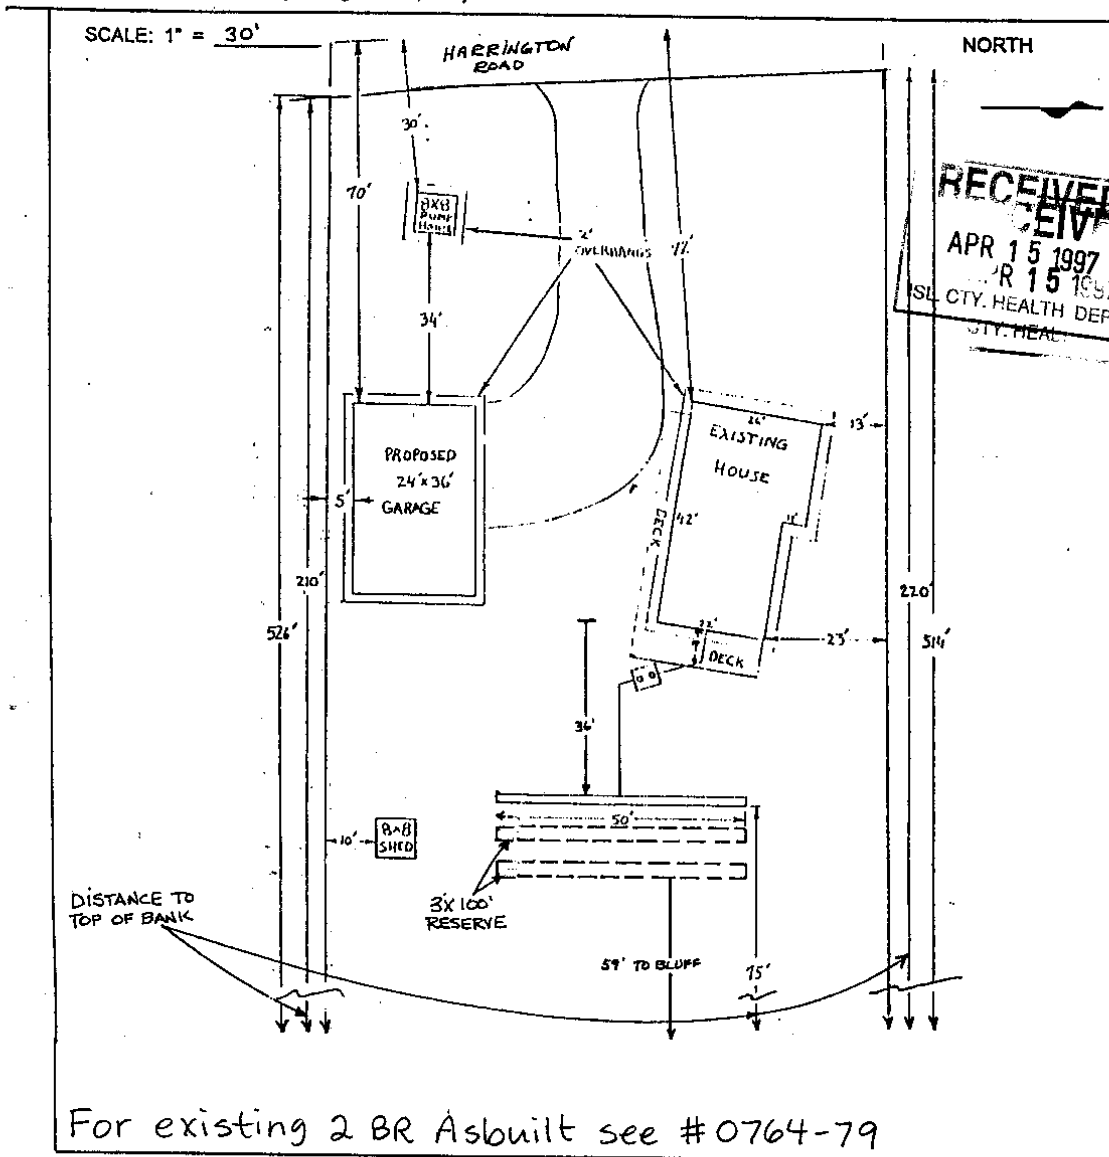

Pump Model/HP: \_\_\_\_\_ (Pump Chamber-PC) \_\_\_\_\_ (Sandfilter-SF)  
 Pump Cycle Time/Dose: min. \_\_\_\_\_ sec. \_\_\_\_\_ (PC) min. \_\_\_\_\_ sec. \_\_\_\_\_ (SF) Float Displacement: \_\_\_\_\_ (SF) \_\_\_\_\_ (PC)  
 Float setting and pressure test completed after wiring and Labor & Industry's inspection: YES [ ] NO [ ]

SAND FILTER	PRESSURE DISTRIBUTION SYSTEM or MOUND	
Residual Head: _____ in.	Residual Head/Orifice Diameter/Number of Orifices	
Orifice Diameter: _____ in.	Lat.#1 _____ in./ _____ in./ _____	Lat.#2 _____ in./ _____ in./ _____
Number of Orifices: _____	Lat.#3 _____ in./ _____ in./ _____	Lat.#4 _____ in./ _____ in./ _____
Dose Volume: _____ gals.	Lat.#5 _____ in./ _____ in./ _____	Lat.#6 _____ in./ _____ in./ _____
	Dose Volume: _____ gals.	

DRAINFIELD: Total \_\_\_\_\_ sq.ft. Total Length \_\_\_\_\_ ft. Width \_\_\_\_\_ ft. Trench Depth \_\_\_\_\_  
 Vertical separation between bottom of trench and saturated or impervious soil: \_\_\_\_\_ TANK MANUFACTURER: LIBBEY CONCRETE

COMMENTS: NEW AS-BUILT DRAWN TO SHOW RESERVE AREA

I personally inspected this On-Site Sewage Disposal System and certify that it was installed in accordance with the approved design and complies with the conditions noted on the permit and with I.C.C. 8.07B.

INSTALLER'S SIGNATURE: Robert E Key DATE INSTALLED: \_\_\_\_\_