


This survey shall not be used for construction/permitting purposes without written consent from the land surveyor who has signed and sealed this survey.

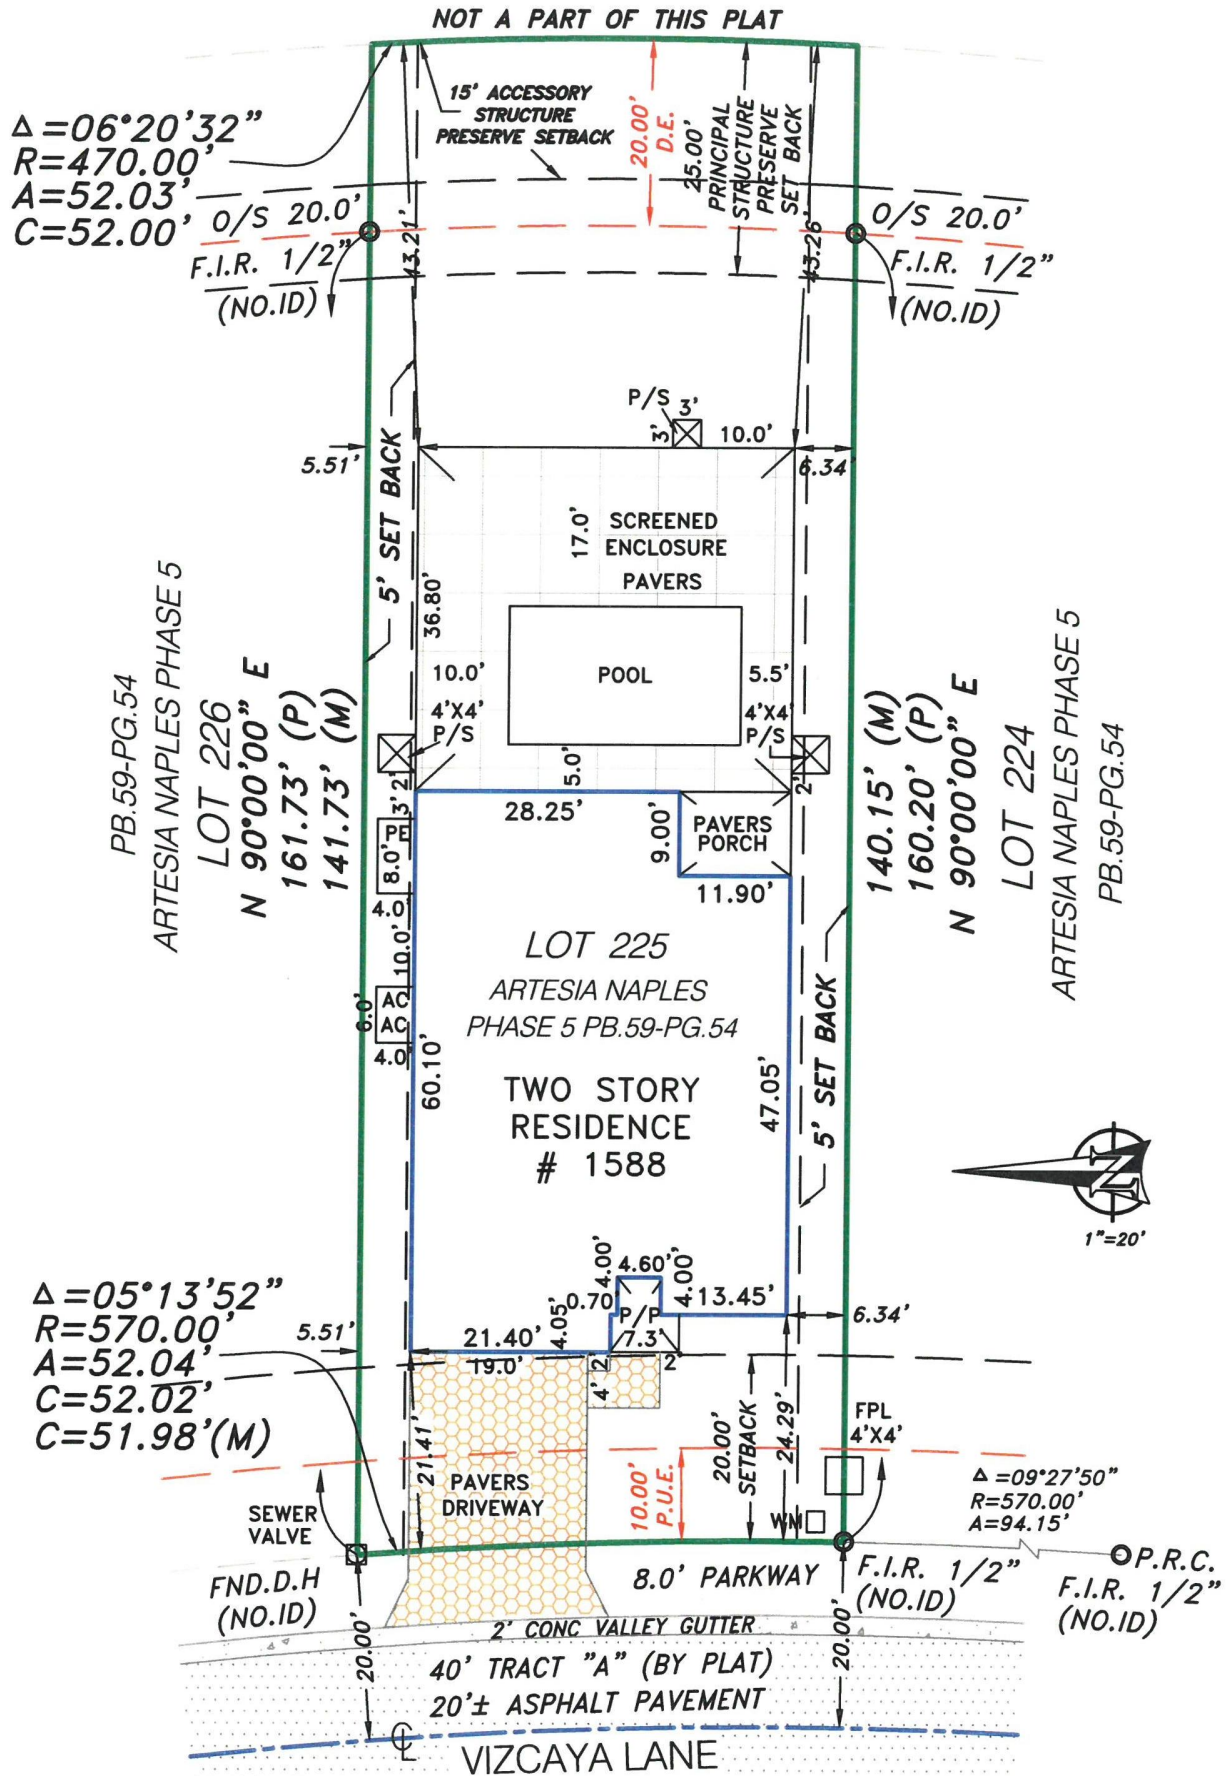

Accepted By: _____

Property Address:
1588 Vizcaya Lane
Naples, FLORIDA 34113

Notes: **PAVER DRIVEWAY LANDS IN THE EASEMENT ALONG WEST LOT LINE.**

SURVEYOR'S CERTIFICATION: I HERBY CERTIFY THAT THIS BOUNDARY SURVEY IS A TRUE AND CORRECT REPRESENTATION OF A SURVEY PREPARED UNDER MY DIRECTION. THIS COMPLIES WITH THE MINIMUM TECHNICAL STANDARDS, AS SET FORTH BY THE STATE OF FLORIDA BOARD OF PROFESSIONAL LAND SURVEYORS IN CHAPTER 5J-17.051 THROUGH 5J-17.052, FLORIDA ADMINISTRATIVE CODE PURSUANT TO 427.027 FLORIDA STATUTES.

SIGNED Jose Roche **FOR THE FIRM**
JOSE ROCHE No. 5935 STATE OF FLORIDA
STATE OF FLORIDA PROFESSIONAL SURVEYOR & MAPPER
P.S.M. No. 5935

NOT VALID WITHOUT AND AUTHENTIC ELECTRONIC SIGNATURE AND AUTHENTICATED ELECTRONIC SEAL AND/OR THIS MAP IS NOT VALID WITHOUT THE SIGNATURE AND THE ORIGINAL RAISED SEAL OF A LICENSED SURVEYOR AND MAPPER.

M.E. Land Surveying, Inc.
10665 SW 190th Street
Suite 3110
Miami, FL 33157
Phone: (305) 740-3319
Fax: (305) 669-3190
LB#: 7989



Surveyor's Legend

| | | |
|--|--|--|
| <p> PROPERTY LINE</p> <p> STRUCTURE</p> <p> CONC. BLOCK WALL</p> <p> CHAIN-LINK FENCE OR WIRE FENCE</p> <p> WOOD FENCE</p> <p> IRON FENCE</p> <p> EASEMENT</p> <p> CENTER LINE</p> <p> WOOD DECK</p> <p> CONCRETE</p> <p> ASPHALT</p> <p> BRICK / TILE</p> <p> WATER</p> <p> APPROXIMATE EDGE OF WATER</p> <p> COVERED AREA</p> <p> TREE</p> <p> POWER POLE</p> <p> CATCH BASIN</p> <p>C.U.E. COUNTY UTILITY EASEMENT</p> <p>I.E./E.E. INGRESS / EGRESS EASEMENT</p> <p>U.E. UTILITY EASEMENT</p> | <p>FND FOUND IRON PIPE / PIN AS NOTED ON PLAT</p> <p>LB# LICENSE # - BUSINESS</p> <p>LS# LICENSE # - SURVEYOR</p> <p>CALC CALCULATED POINT</p> <p>SET SET PIN</p> <p> CONTROL POINT</p> <p> CONCRETE MONUMENT</p> <p> BENCHMARK</p> <p>ELEV ELEVATION</p> <p>P.T. POINT OF TANGENCY</p> <p>P.C. POINT OF CURVATURE</p> <p>P.R.M. PERMANENT REFERENCE MONUMENT</p> <p>P.C.C. POINT OF COMPOUND CURVATURE</p> <p>P.R.C. POINT OF REVERSE CURVATURE</p> <p>P.O.B. POINT OF BEGINNING</p> <p>P.O.C. POINT OF COMMENCEMENT</p> <p>P.C.P. PERMANENT CONTROL POINT</p> <p>M FIELD MEASURED</p> <p>P PLATTED MEASUREMENT</p> <p>D DEED</p> <p>C CALCULATED</p> <p>L.M.E. LAKE OR LANDSCAPE MAINT. ESMT.</p> <p>R.O.E. ROOF OVERHANG EASEMENT</p> | <p>B.R. BEARING REFERENCE</p> <p> CENTRAL ANGLE OR DELTA</p> <p>R RADIUS OR RADIAL</p> <p>RAD. RADIAL TIE</p> <p>N.R. NON RADIAL</p> <p>TYP. TYPICAL</p> <p>I.R. IRON ROD</p> <p>I.P. IRON PIPE</p> <p>N&D NAIL & DISK</p> <p>PK NAIL PARKER-KALON NAIL</p> <p>D.H. DRILL HOLE</p> <p> WELL</p> <p> FIRE HYDRANT</p> <p> M.H. MANHOLE</p> <p>O.H.L. OVERHEAD LINES</p> <p>TX TRANSFORMER</p> <p>CATV CABLE TV RISER</p> <p>W.M. WATER METER</p> <p>P/E POOL EQUIPMENT</p> <p>CONC. CONCRETE SLAB</p> <p>ESMT EASEMENT</p> <p>D.E. DRAINAGE EASEMENT</p> <p>L.B.E. LANDSCAPE BUFFER EASEMENT</p> <p>L.A.E. LIMITED ACCESS EASEMENT</p> |
| | | <p>TEL. TELEPHONE FACILITIES</p> <p>U.P. UTILITY POLE</p> <p>E.U.B. ELECTRIC UTILITY BOX</p> <p>SEP. SEPTIC TANK</p> <p>D.F. DRAINFIELD</p> <p>A/C AIR CONDITIONER</p> <p>S/W SIDEWALK</p> <p>DWY DRIVEWAY</p> <p>SCR. SCREEN</p> <p>GAR GARAGE</p> <p>ENCL. ENCLOSURE</p> <p>N.T.S. NOT TO SCALE</p> <p>F.F. FINISHED FLOOR</p> <p>T.O.B. TOP OF BANK</p> <p>E.O.W. EDGE OF WATER</p> <p>E.O.P. EDGE OF PAVEMENT</p> <p>C.V.G. CONCRETE VALLEY GUTTER</p> <p>B.S.L. BUILDING SETBACK LINE</p> <p>S.T.L. SURVEY TIE LINE</p> <p> CENTER LINE</p> <p>R/W RIGHT-OF-WAY</p> <p>P.U.E. PUBLIC UTILITY EASEMENT</p> <p>C.M.E. CANAL MAINTENANCE EASEMENT</p> <p>A.E. ANCHOR EASEMENT</p> |

Property Address:

1588 Vizcaya Lane
Naples, FLORIDA 34113

Flood Information:

Community Number: 120067
Panel Number: 12021C0615H
Suffix: H
Date of Firm Index: 05/16/2012
Flood Zone: AE
Base Flood Elevation: 6.0
Date of Field Work: 06/08/2020
Date of Completion: 06/12/2020

General Notes:

- 1.) The Legal Description used to perform this survey was supplied by others. This survey does not determine or is not to imply ownership
- 2.) This survey only shows above ground improvements. Underground utilities, footings, or encroachments are not located on this survey map
- 3.) If there is a septic tank, well, or drain field on this survey, the location of such items was shown to us by others and the information was not verified.
- 4.) Examination of the abstract of title will have to be made to determine recorded instruments, if any, effect this property. The lands shown herein were not abstracted for easement or other recorded encumbrances not shown on the plat
- 5.) Wall ties are done to the face of the wall.
- 6.) Fence ownership is not determined.
- 7.) Bearings referenced to line noted B.R
- 8.) Dimensions shown are platted and measured unless otherwise shown.
- 9.) No identification found on property corners unless noted.
- 10.) Not valid unless sealed with the signing surveyors embossed seal.
- 11.) Boundary survey means a drawing and/or graphic representation of the survey work performed in the field, could be drawn at a shown scale and/or not to scale
- 12.) Elevations if shown are based upon NGVD 1929 unless otherwise noted
- 13.) This is a BOUNDARY SURVEY unless otherwise noted.
- 14.) This survey is exclusive for the use of the parties to whom it is certified. The certifications do not extend to any unnamed parties.
- 15.) This survey shall not be used for construction/permitting purposes without written consent from the land surveyor who has signed and sealed this survey.

Legal Description:

Lot 225, of ARTESIA NAPLES PHASE 5, according to the plat thereof, as recorded in Plat Book 59, Page 54, of the public records of Collier County, FLORIDA

Printing Instructions:

While viewing the survey in any PDF Reader, select the File Drop-down and select "Print". Select a color printer, if available; or at least one with 8.5" x 14" (legal) paper.
Select ALL for Print Range, and the # of copies you would like to print out.
Under the "Page Scaling" please make sure you have selected "None".
Do not check the "Auto-rotate and Center" box.
Check the "Choose Paper size by PDF" checkbox, then click OK to print.

Certified To:

Troy Broitzman and Quenby A. Broitzman
Cottrell Title & Escrow
Westcor Land Title Insurance Company
Lake Michigan Credit Union / Florida Lending Division
its successors and/or assigns as their interest may appear.

Please copy below for policy preparation purposes only:

This policy does not insure against loss or damage by reason of the following exceptions: Any rights, easements, interests, or claims which may exist by reason of, or reflected by, the following facts shown on the survey prepared by Jose Roche dated 06/12/2020 bearing Job # B-73355 :
a. *PAVER DRIVEWAY LANDS IN THE EASEMENT ALONG WEST LOT LINE.*

M.E. Land Surveying, Inc.

10665 SW 190th Street, Suite 3110 Miami, FL 33157
Phone: (305) 740-3319
Fax: (305) 669-3190
LB#: 7989

