

AS-BUILT INFORMATION: (Prepared by Environmental Health Department)

Legal Address: Lot 2 Anacanda + Daisy

Tank Capacity 1500 + dose Gallons No. Compartments 2 + dose Material concrete

Depth to Top of Tank 36 " Risers Y N Height of Risers 36 "

Type and Model of Dosing Device Oranco PF300511


Field Dimensions 3 @ 12 ' x 25 ' Total Sq. Ft. 600 '

Avg. Field Depth 12 " Height of Filter Material 48 "

System Contractor Snowbridge

New Construction System Repair System Replacement

Permit # OWS16-0036 If this drawing is not a complete representation of OWTS see also permit# OWS _____

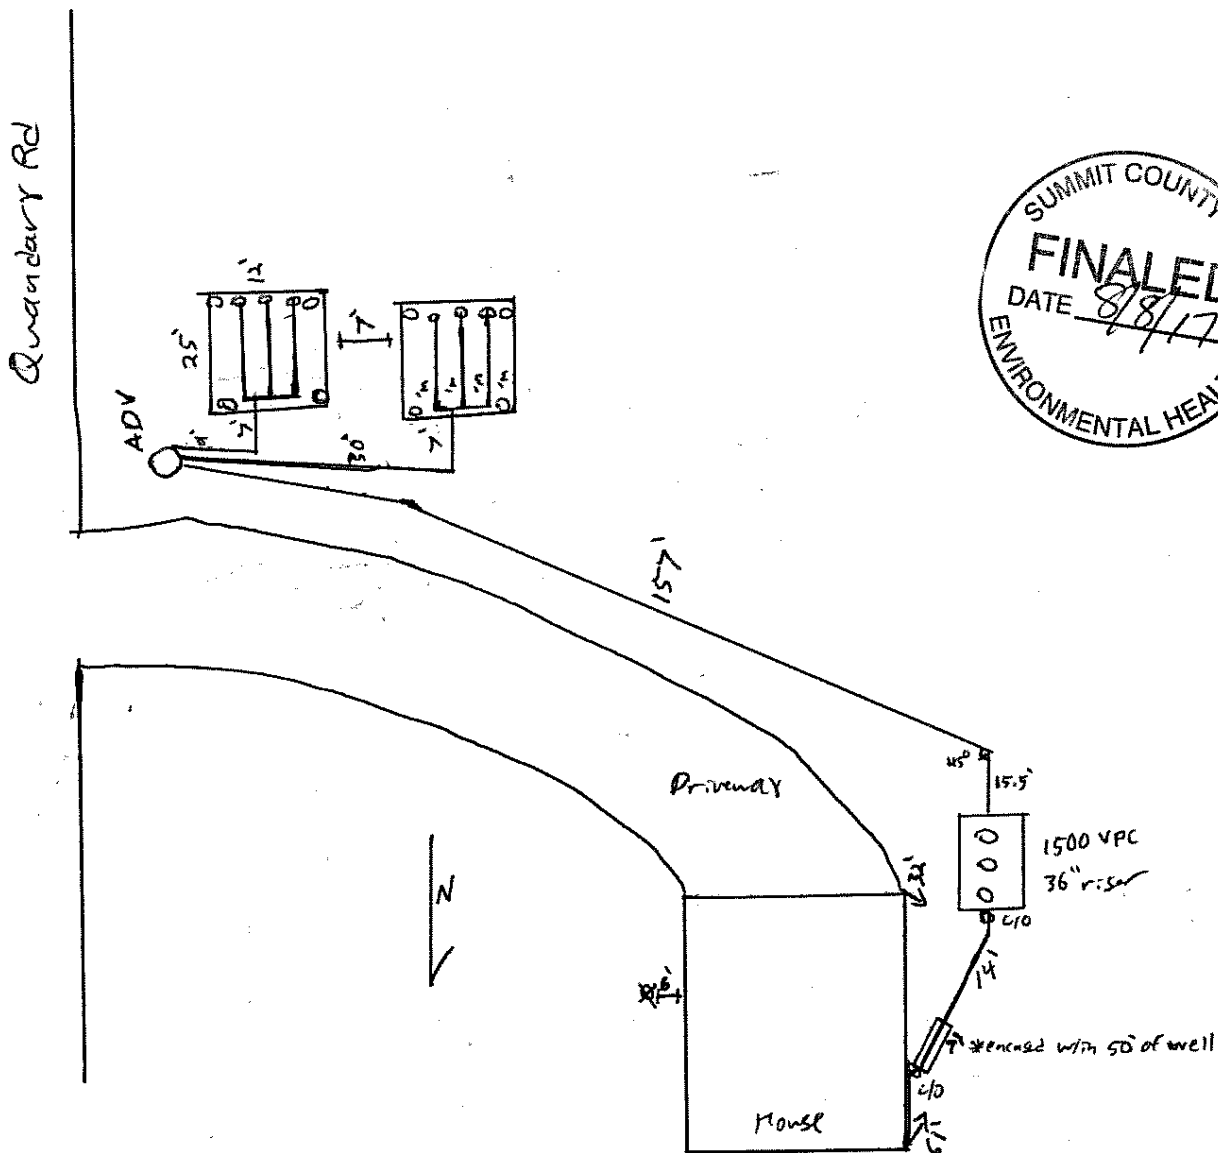

8624