


BLOCK 50003.01

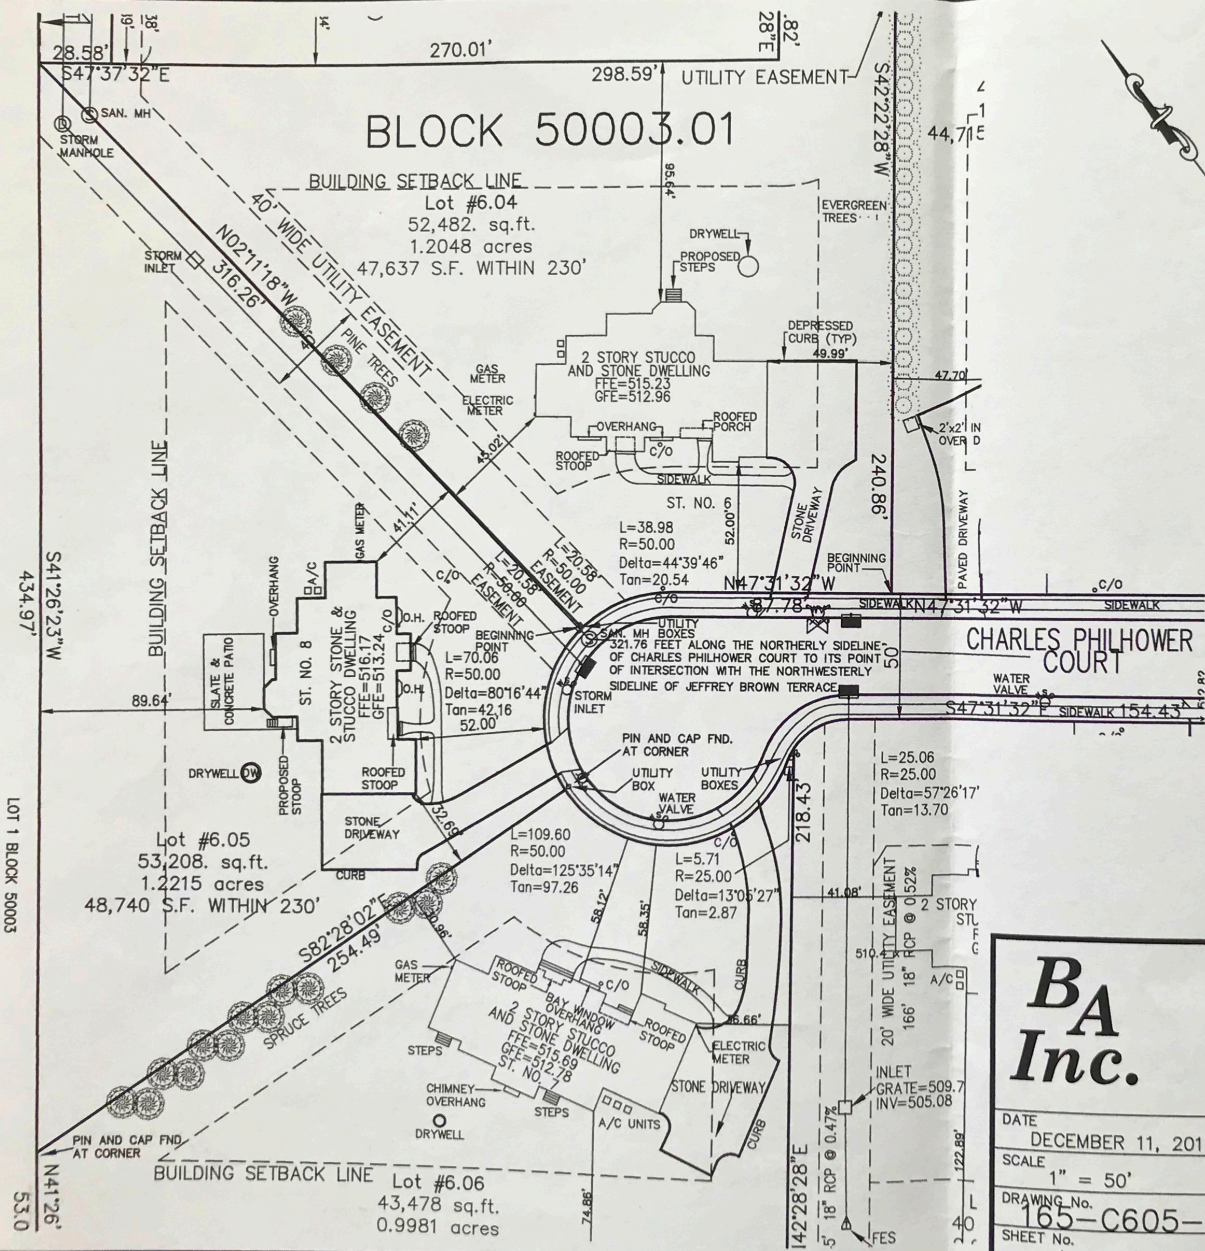

MORRIS COUNTY, NEW JERSEY
 Certified To: Jeffrey and
 Lorraine Barber Miller husband and wife;
 Agility Title, LLC, Westcor Title Insurance
 Company and Wells Fargo Bank, its
 successors and/or assigns as their
 interest may appear.

"THIS CERTIFICATION IS MADE ONLY TO ABOVE - NAMED PARTIES FOR PURCHASE AND / OR MORTGAGE OF HEREIN DELINEATED PROPERTY BY ABOVE - NAMED PURCHASER. NO RESPONSIBILITY OR LIABILITY IS ASSUMED BY THE SURVEYOR FOR USE OF SURVEY FOR ANY OTHER PURPOSE INCLUDING, BUT NOT LIMITED TO, USE OF SURVEY FOR SURVEY AFFIDAVIT, RESALE OF PROPERTY, OR TO ANY OTHER PERSON NOT LISTED IN CERTIFICATION, EITHER DIRECTLY OR INDIRECTLY."

REFERENCE: MAP ENTITLED "AMENDED FINAL PLAT, LOTS 2,6,8, AND PORTIONS OF 10 & 12, BLOCK 50003 AND LOT 7 BLOCK 50702, TOWNSHIP OF DENVILLE, MORRIS COUNTY, NEW JERSEY", DATED APRIL 25, 2006 AND REVISED APRIL 8, 2011 AND FILED IN THE MORRIS COUNTY CLERK'S OFFICE IN BOOK 8, PAGE 13.

A WRITTEN WAIVER AND DIRECTION NOT TO SET CORNER MARKERS HAS BEEN OBTAINED FROM THE ULTIMATE USER, JEFFREY MILLER, PURSUANT TO THE BOARD OF PROFESSIONAL ENGINEERS AND LAND SURVEYORS REGULATION, P.L.2003,c.14 (N.J.S.A. 45:8-36.3) AND N.J.A.C. 13:40-5.1(d).

FINAL AS-BUILT SURVEY
 LOT 6.05 BLOCK 50003.01
 TOWNSHIP OF DENVILLE
 MORRIS COUNTY, NEW JERSEY

BA
Inc.

BRICKER and ASSOCIATES, INC.
 CONSULTING CIVIL ENGINEERS, PLANNERS, and
 PROFESSIONAL LAND SURVEYORS
 37 MOUNT PLEASANT TURNPIKE DENVILLE, NEW JERSEY 07834
 TEL (973) 989-1120 FAX (973) 989-3930
 CERTIFICATE OF AUTHORIZATION #24GA27962800

DATE DECEMBER 11, 2017	DRAWN BY M.B.	CHECKED BY M.B.	FIELD BOOK / PAGE
SCALE 1" = 50'	FOR THE FIRM		
DRAWING No. 165-C605-F			
SHEET No. 1 OF 1	<p>MARC A. BRICKER PROFESSIONAL LAND SURVEYOR N.J. LICENSE No. 37988</p>		