


Zone Area Schedule				
Room #	Home Story	Floor Area	Area	Type
FLOOR AREA				
	Lower Level	1. HEATED LOWER	1,253.97	Internal Heated Zone
	Lower Level	1. N/H LOWER	1,166.96	Internal N/H
	Main Level	1. HEATED MAIN	2,401.88	Internal Heated Zone
	Main Level	2. MAIN PORCH	345.19	External / Covered
	Main Level	3. PORCH	107.59	External / Covered
	Main Level	4. FRONT PORCH	56.22	External / Covered
	Upper Level	1. HEATED UPPER	1,008.00	Internal Heated Zone
			6,339.81 ft²	

Sheet Index		
AS Built Drawings		
	AS BUILT-1	0. Lower Level
	AS BUILT-2	0. Main Level
	AS BUILT-3	1. Upper Level
	AS BUILT-4	Generic View / MAIN
	AS BUILT-5	Generic View / LOWER
	AS BUILT-6	Generic View / UPPER

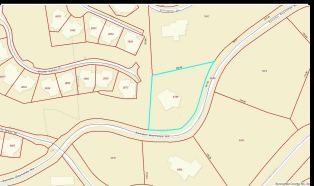

PROJECT LOCATION MAP


GENERAL NOTES:
1. DO NOT USE AS A BLUEPRINTS WITHOUT MR LLC PERMISSION.
2. PLEASE NOTE INTERIOR DIMENSIONS WERE NOT USED IN CALCULATING SQUARE FOOTAGE.
3. SIZE OF HEATED AND NOT HEATED AREA AND OTHER INFORMATION WERE OBTAINED PER THE NC REAL ESTATE COMMISSION GUIDELINES (6" FOR EXTERNAL WALLS EXCEPT CONDOMINIUMS).
4. FOR REMODELING QUESTIONS OR MORE DETAILED CAD DRAWINGS (INC.SITE PLAN, SECTIONS, ELEVATIONS) ALSO 3D MODEL PLEASE CONTACT ALFRED ZALYS MOB. 828 231 7305 E-MAIL: A.ZALYS@HOTMAIL.COM
5. THE FURNITURE SHOWN IS FOR ILLUSTRATIVE PURPOSES ONLY, INTENDED TO ENHANCE MARKETING VISUALS AND BETTER UNDERSTAND SPACE DESIGN

Client:

#Client E-mail
#Client Phone Number

LEGEND MAP:
HEATED COMMERC. FINISHED
HEATED RESIDENTIAL FINISHED
NOT HEATED/NOT FINISHED
COVERED PORCH
OPEN DECK

Revision History

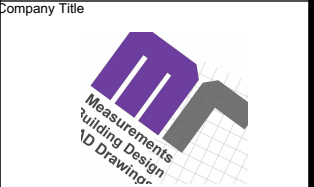

Company
Measure Rite LLC
103 Poplar Spring Trl. Hendersonville
Henderson County 28739


Site Address
**136 Senator Reynolds Rd,
Asheville, NC 28804**

Drawing Name
**Main Level, Building Area
Schedule, Sheet Index**

Drawing Status
AS BUILT

Contact Name Alfred ZALYS mob. 828 231 7305	Job Nr. MR 1215 Date 8/9/2025
Drawing Scale 1/8" = 1'-0"	Layouts Total 5
Layout Nr. 5	Paper Size ANSI B
Layout ID AS BUILT-2	Revision

TOTAL HEATED: 4,663.85 SQ.FT.

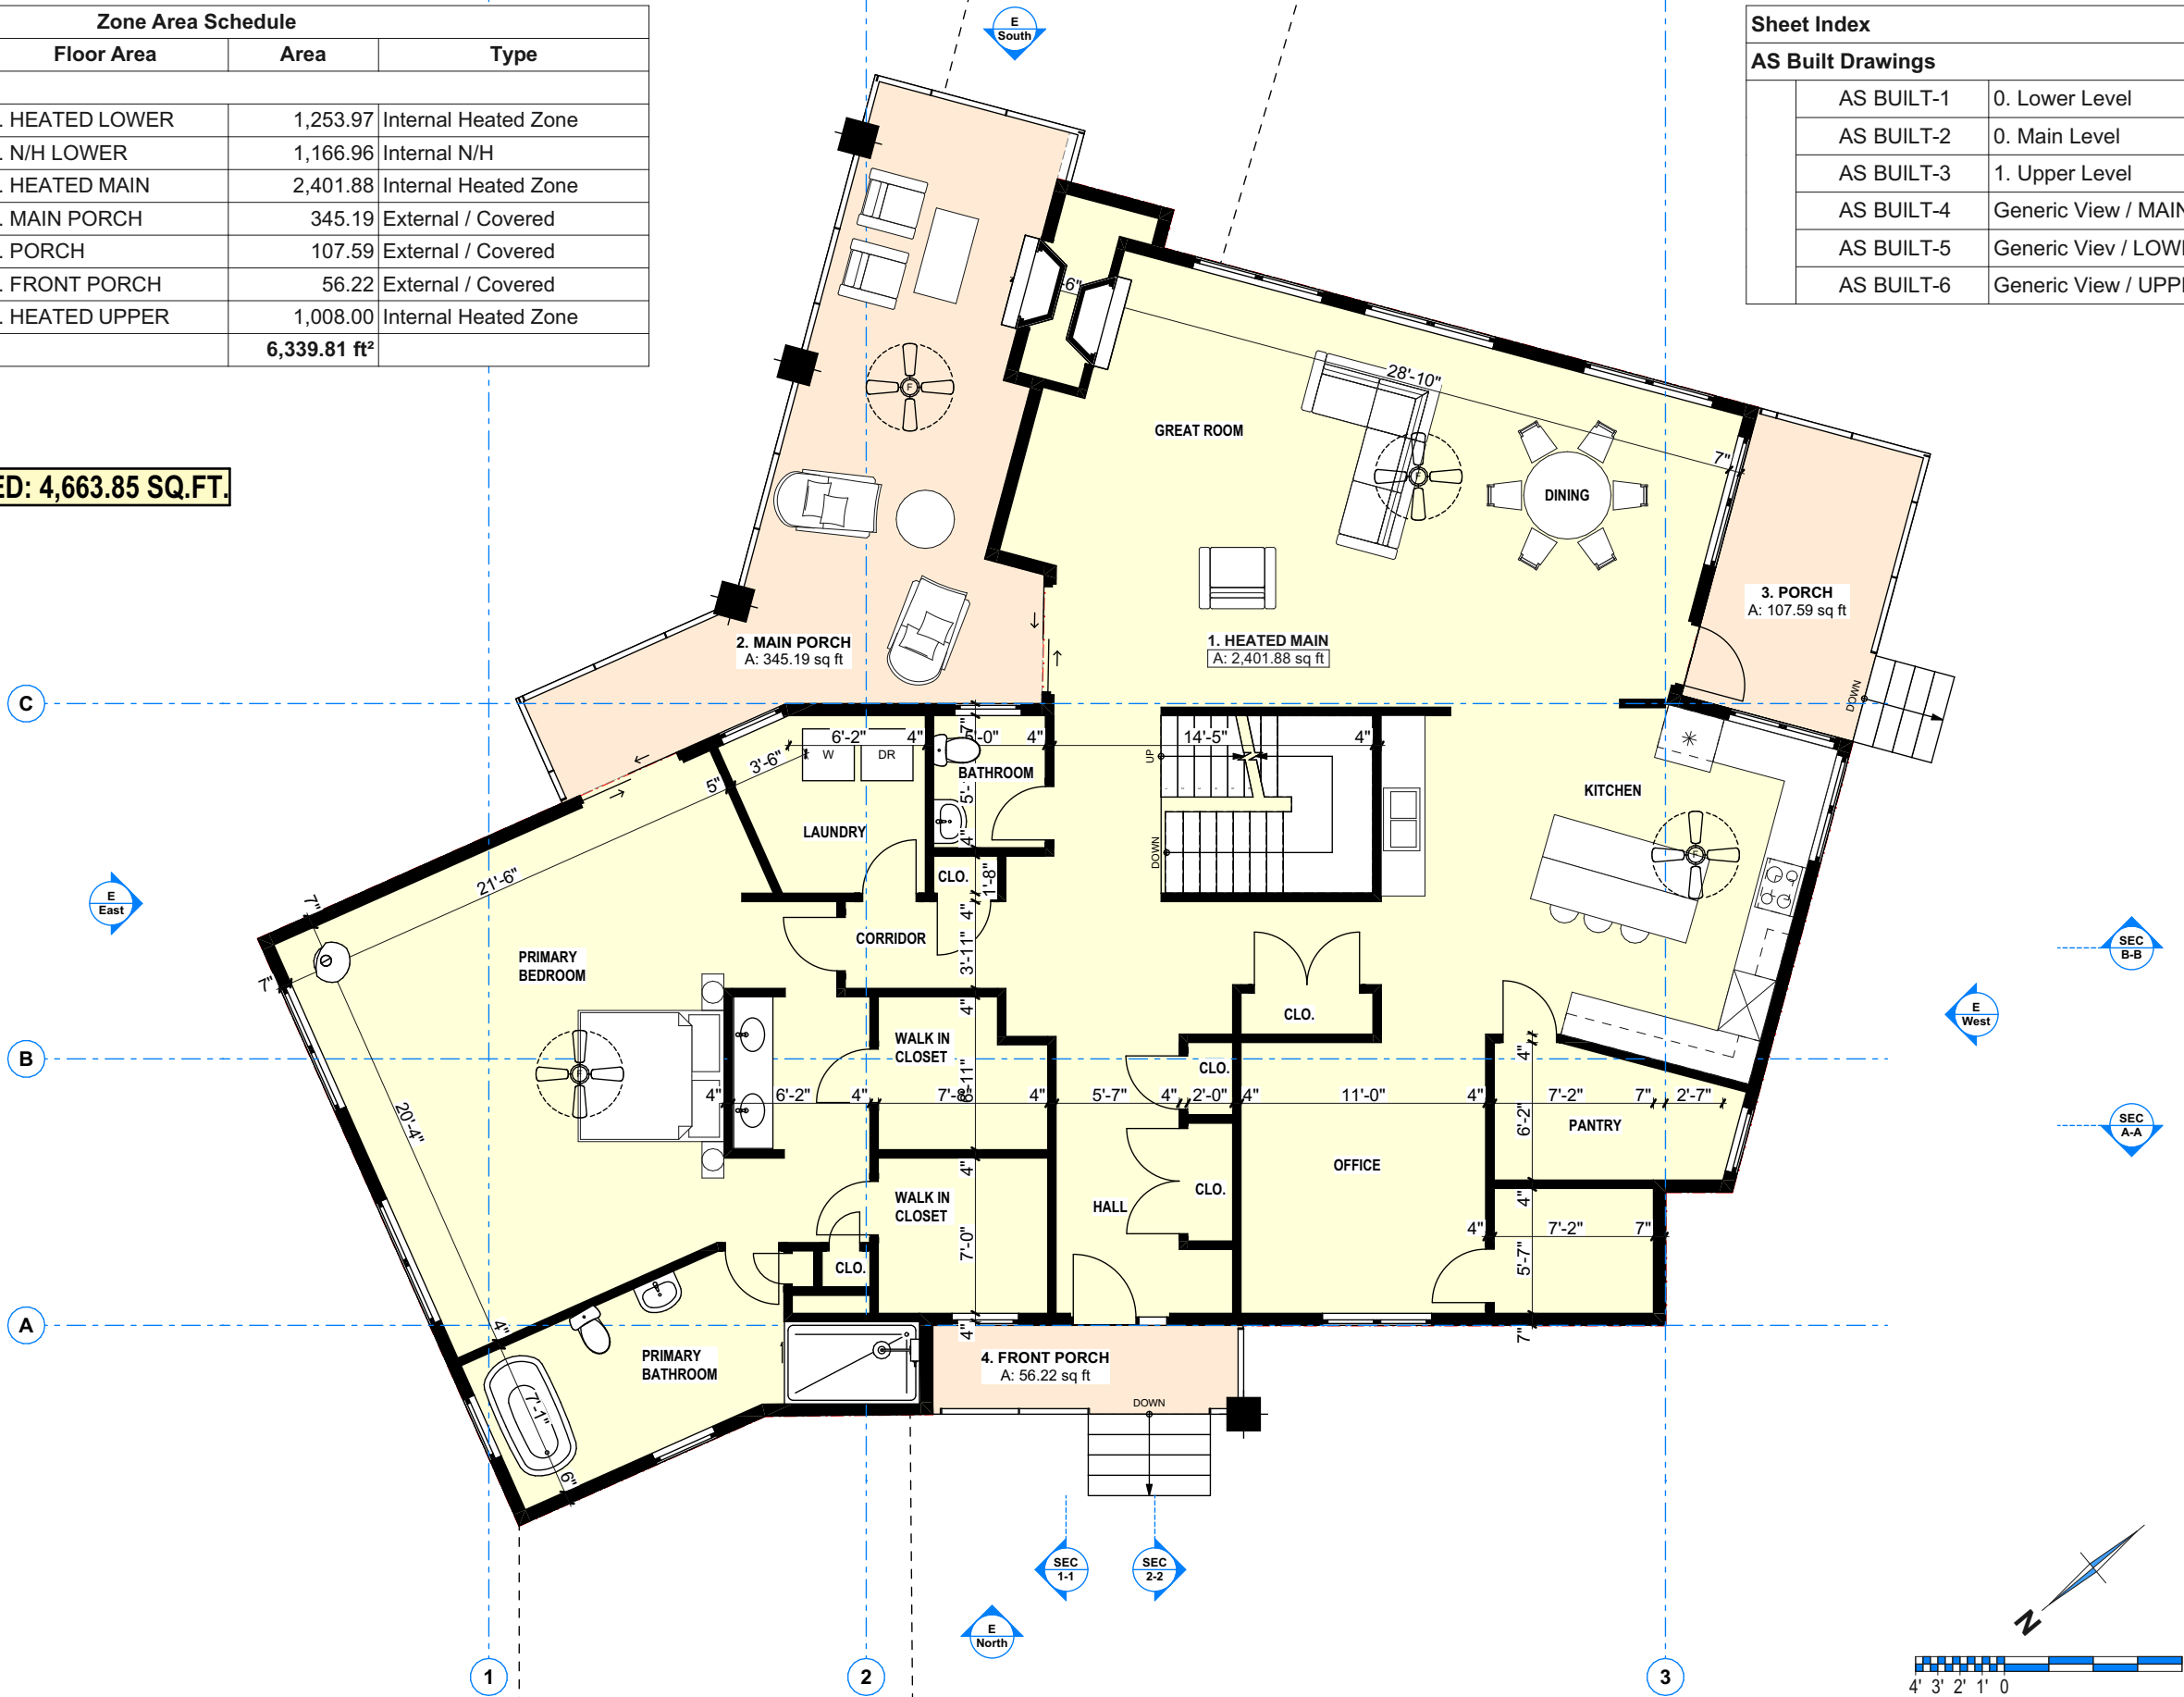


AS BUILT-2

Main Level

1/8" = 1'-0"

Zone Area Schedule				
Room #	Home Story	Floor Area	Area	Type
FLOOR AREA				
	Lower Level	1. HEATED LOWER	1,253.97	Internal Heated Zone
	Lower Level	1. N/H LOWER	1,166.96	Internal N/H
	Main Level	1. HEATED MAIN	2,401.88	Internal Heated Zone
	Main Level	2. MAIN PORCH	345.19	External / Covered
	Main Level	3. PORCH	107.59	External / Covered
	Main Level	4. FRONT PORCH	56.22	External / Covered
	Upper Level	1. HEATED UPPER	1,008.00	Internal Heated Zone
			6,339.81 ft²	

Sheet Index		
AS Built Drawings		
	AS BUILT-1	0. Lower Level
	AS BUILT-2	0. Main Level
	AS BUILT-3	1. Upper Level
	AS BUILT-4	Generic View / MAIN
	AS BUILT-5	Generic View / LOWER
	AS BUILT-6	Generic View / UPPER

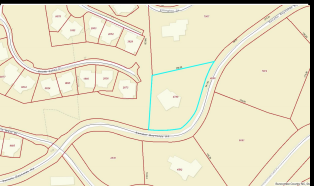

PROJECT LOCATION MAP


GENERAL NOTES:
1. DO NOT USE AS A BLUEPRINTS WITHOUT MR LLC PERMISSION.
2. PLEASE NOTE INTERIOR DIMENSIONS WERE NOT USED IN CALCULATING SQUARE FOOTAGE.
3. SIZE OF HEATED AND NOT HEATED AREA AND OTHER INFORMATION WERE OBTAINED PER THE NC REAL ESTATE COMMISSION GUIDELINES (6" FOR EXTERNAL WALLS EXCEPT CONDOMINIUMS).
4. FOR REMODELING QUESTIONS OR MORE DETAILED CAD DRAWINGS (INC.SITE PLAN, SECTIONS, ELEVATIONS) ALSO 3D MODEL PLEASE CONTACT ALFRED ZALYS
MOB. 828 231 7305 E-MAIL: A.ZALYS@HOTMAIL.COM
5. THE FURNITURE SHOWN IS FOR ILLUSTRATIVE PURPOSES ONLY, INTENDED TO ENHANCE MARKETING VISUALS AND BETTER UNDERSTAND SPACE DESIGN

Client:

#Client E-mail
#Client Phone Number

LEGEND MAP:
HEATED COMMERC. FINISHED
HEATED RESIDENTIAL FINISHED
NOT HEATED/NOT FINISHED
COVERED PORCH
OPEN DECK

Revision History

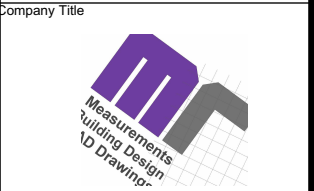


Company
Measure Rite LLC
103 Poplar Spring Trl. Hendersonville
Henderson County 28739

Site Address
**136 Senator Reynolds Rd,
Asheville, NC 28804**

Drawing Name
**Lower Level, Building Area
Schedule, Sheet Index**

Drawing Status
AS BUILT

Contact Name Alfred ZALYS mob. 828 231 7305	Job Nr. MR 1215 Date 8/9/2025
Drawing Scale 1/8" = 1'-0" 1:1.63, 1:1.43	Layouts Total 5
Layout Nr.	Paper Size ANSI B
Layout ID AS BUILT-1	Revision

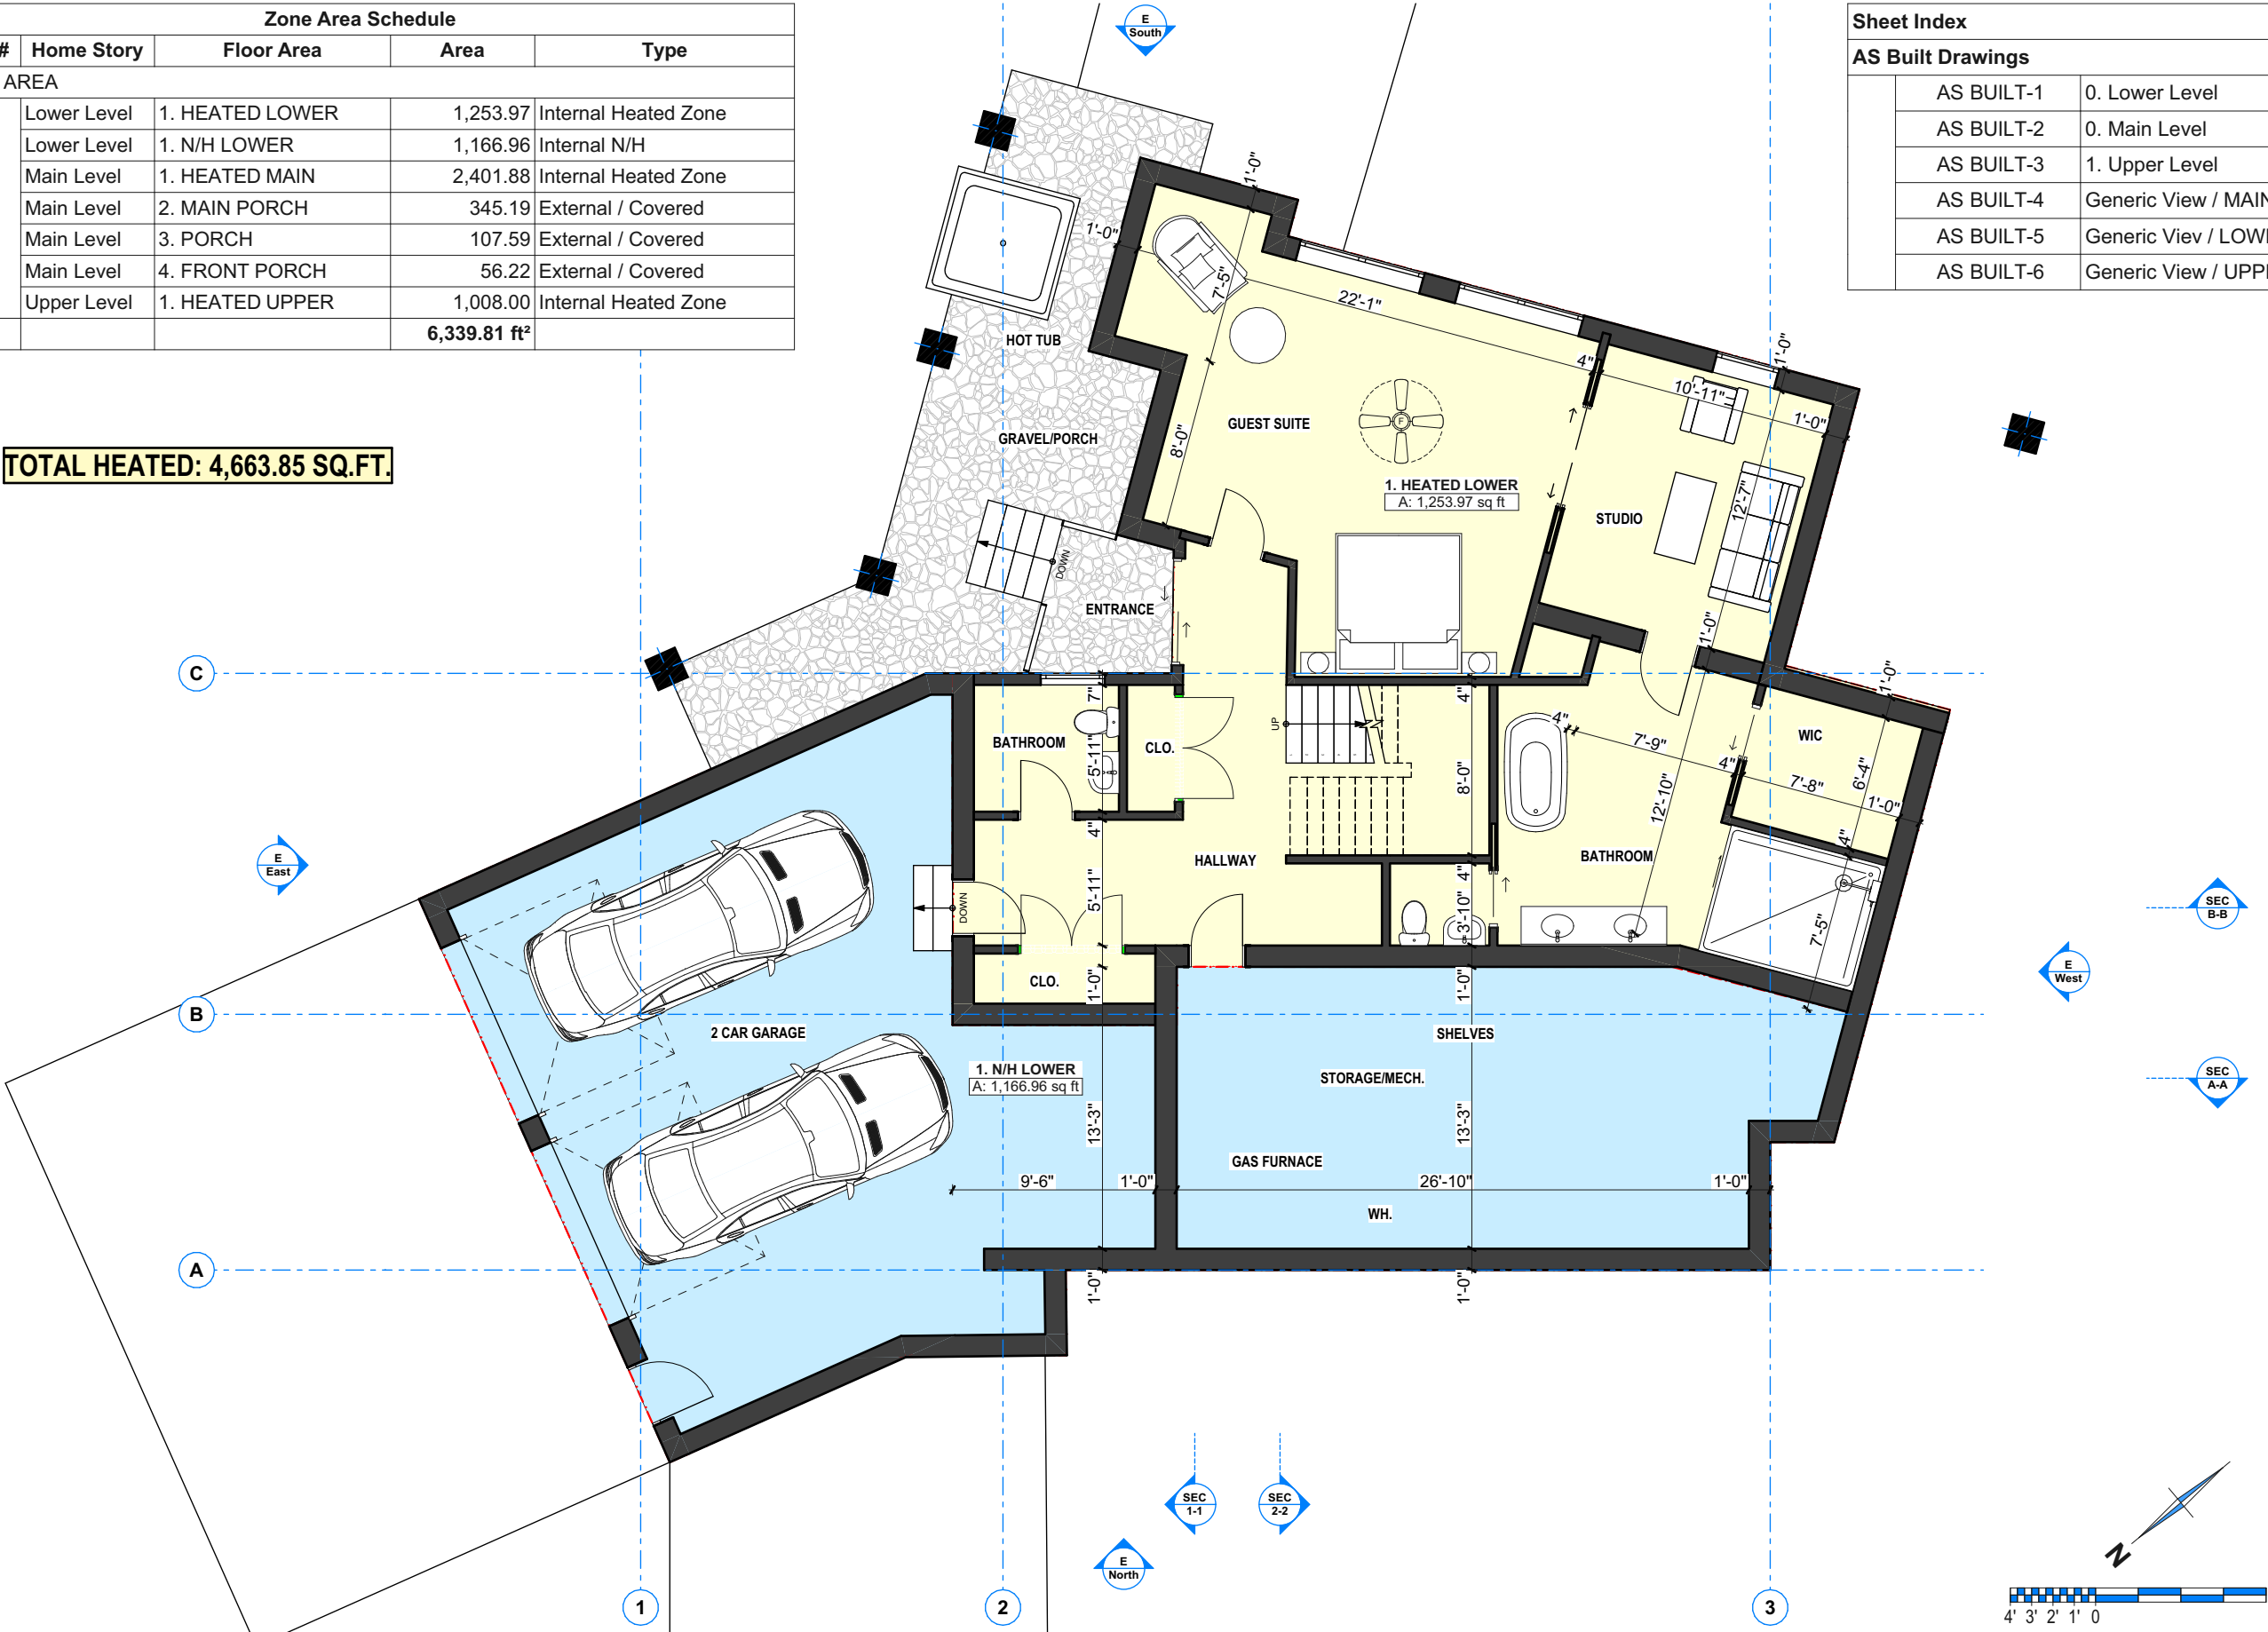


AS BUILT-1

Lower Level

1/8" = 1'-0"

Zone Area Schedule				
Room #	Home Story	Floor Area	Area	Type
FLOOR AREA				
	Lower Level	1. HEATED LOWER	1,253.97	Internal Heated Zone
	Lower Level	1. N/H LOWER	1,166.96	Internal N/H
	Main Level	1. HEATED MAIN	2,401.88	Internal Heated Zone
	Main Level	2. MAIN PORCH	345.19	External / Covered
	Main Level	3. PORCH	107.59	External / Covered
	Main Level	4. FRONT PORCH	56.22	External / Covered
	Upper Level	1. HEATED UPPER	1,008.00	Internal Heated Zone
			6,339.81 ft²	

Sheet Index		
AS Built Drawings		
	AS BUILT-1	0. Lower Level
	AS BUILT-2	0. Main Level
	AS BUILT-3	1. Upper Level
	AS BUILT-4	Generic View / MAIN
	AS BUILT-5	Generic View / LOWER
	AS BUILT-6	Generic View / UPPER

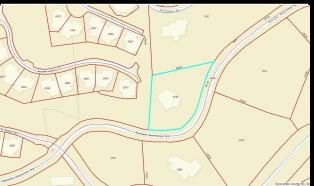

PROJECT LOCATION MAP


GENERAL NOTES:
1. DO NOT USE AS A BLUEPRINTS WITHOUT MR LLC PERMISSION.
2. PLEASE NOTE INTERIOR DIMENSIONS WERE NOT USED IN CALCULATING SQUARE FOOTAGE
3. SIZE OF HEATED AND NOT HEATED AREA AND OTHER INFORMATION WERE OBTAINED PER THE NC REAL ESTATE COMMISSION GUIDELINES (6" FOR EXTERNAL WALLS EXCEPT CONDOMINIUMS)
4. FOR REMODELING QUESTIONS OR MORE DETAILED CAD DRAWINGS (INC.SITE PLAN, SECTIONS, ELEVATIONS) ALSO 3D MODEL PLEASE CONTACT ALFRED ZALYS
MOB. 828 231 7305 E-MAIL: A.ZALYS@HOTMAIL.COM
5. THE FURNITURE SHOWN IS FOR ILLUSTRATIVE PURPOSES ONLY, INTENDED TO ENHANCE MARKETING VISUALS AND BETTER UNDERSTAND SPACE DESIGN

Client:

#Client E-mail
#Client Phone Number

LEGEND MAP:
HEATED COMMERC. FINISHED
HEATED RESIDENTIAL FINISHED
NOT HEATED/NOT FINISHED
COVERED PORCH
OPEN DECK

Revision History

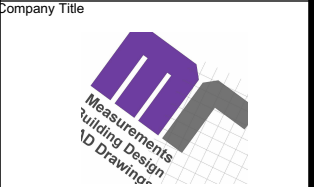

Company
Measure Rite LLC
103 Poplar Spring Trl. Hendersonville
Henderson County 28739


Site Address
**136 Senator Reynolds Rd,
Asheville, NC 28804**

Drawing Name
**Upper Level, Building Area
Schedule, Sheet Index**

Drawing Status
AS BUILT

Contact Name Alfred ZALYS mob. 828 231 7305	Job Nr. MR 1215 Date 8/9/2025
Drawing Scale 1/8" = 1'-0" 1:1.63, 1:1.43	Layouts Total 5
Layout Nr.	Paper Size ANSI B
Layout ID AS BUILT-3	Revision


TOTAL HEATED: 4,663.85 SQ.FT.

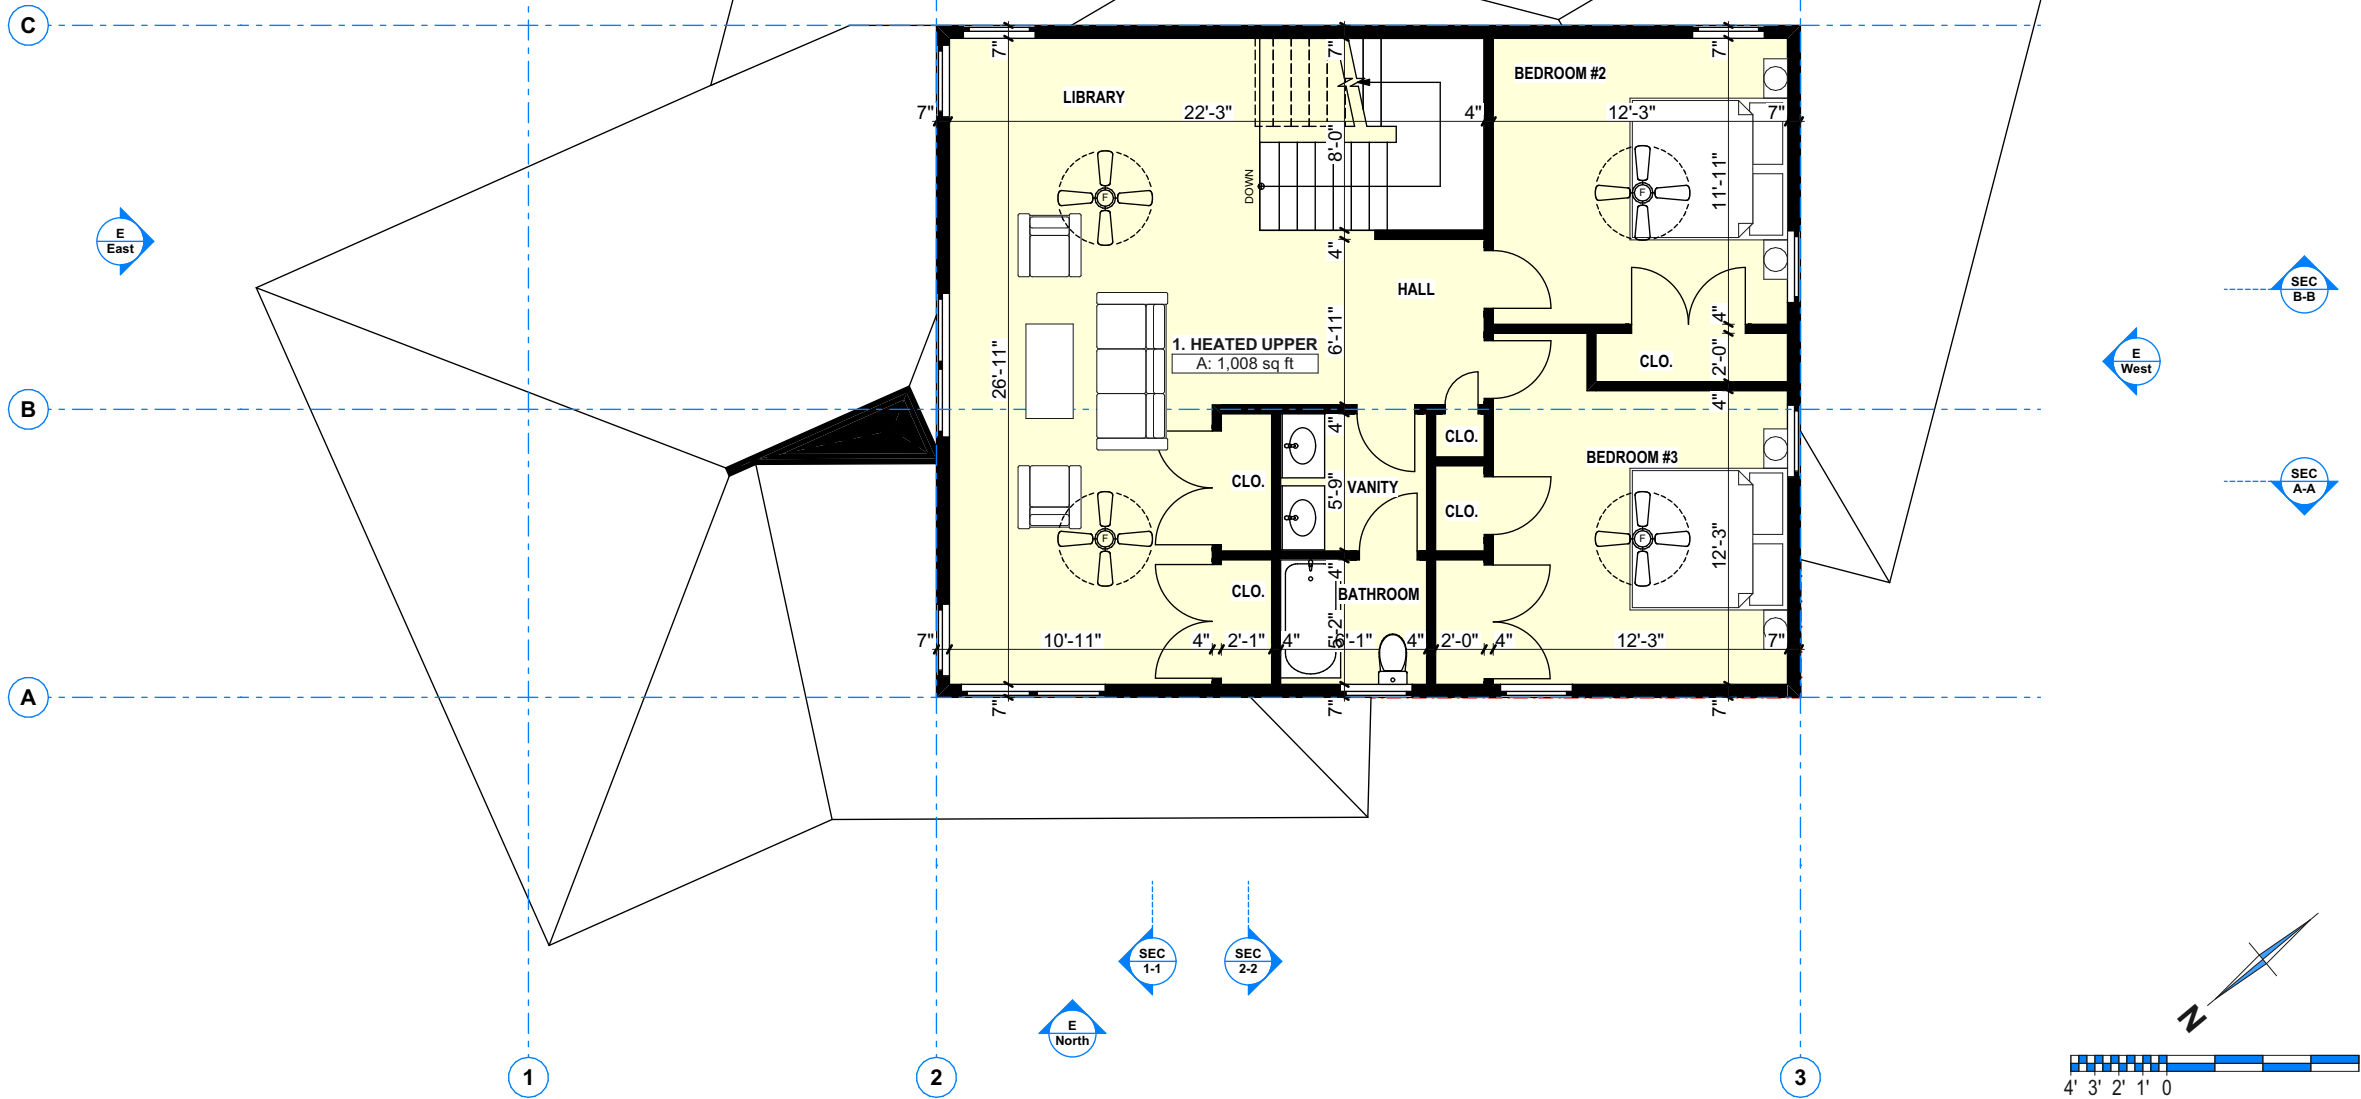


AS BUILT-3

Upper Level

1/8" = 1'-0"

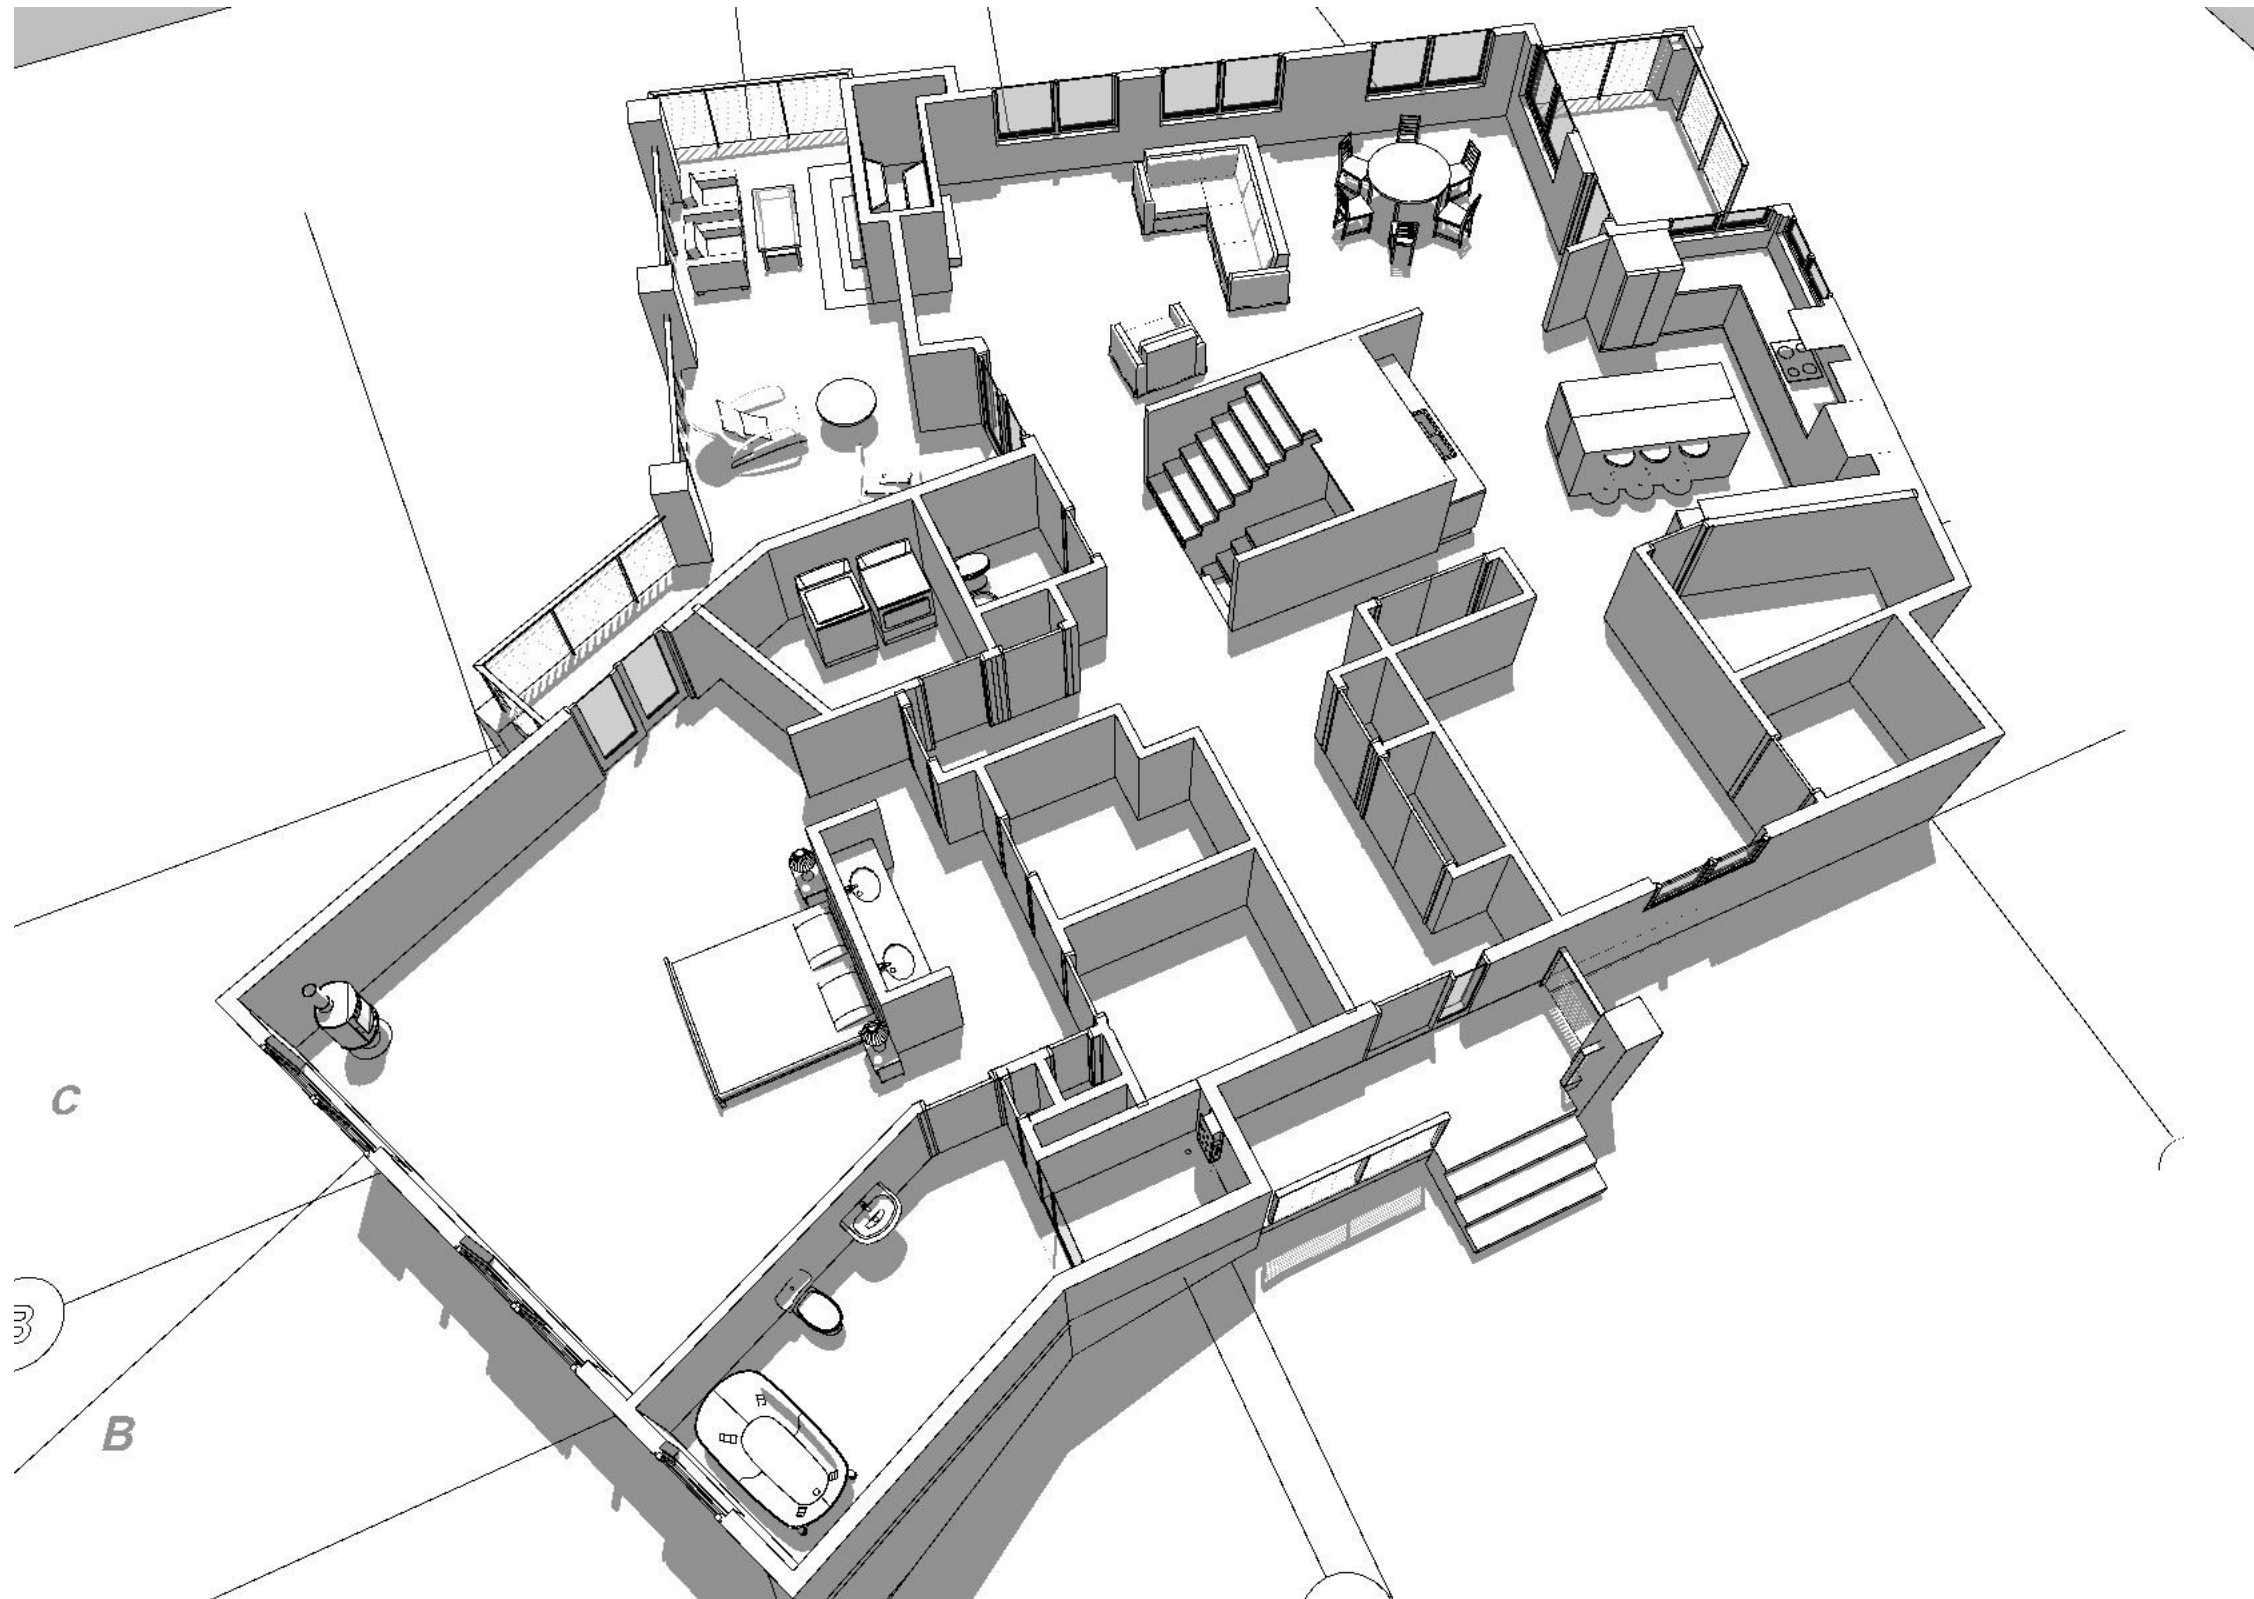

Generic Perspective / MAIN

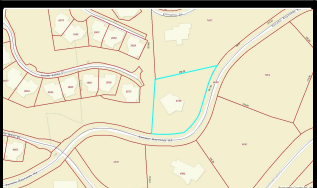

PROJECT LOCATION MAP


GENERAL NOTES:
1. DO NOT USE AS A BLUEPRINTS WITHOUT MR LLC PERMISSION.
2. PLEASE NOTE INTERIOR DIMENSIONS WERE NOT USED IN CALCULATING SQUARE FOOTAGE
3. SIZE OF HEATED AND NOT HEATED AREA AND OTHER INFORMATION WERE OBTAINED PER THE NC REAL ESTATE COMMISSION GUIDELINES (6" FOR EXTERNAL WALLS EXCEPT CONDOMINIUMS)
4. FOR REMODELING QUESTIONS OR MORE DETAILED CAD DRAWINGS (INC.SITE PLAN, SECTIONS, ELEVATIONS) ALSO 3D MODEL PLEASE CONTACT ALFRED ZALYS
MOB. 828 231 7305 E-MAIL: A.ZALYS@HOTMAIL.COM
5. THE FURNITURE SHOWN IS FOR ILLUSTRATIVE PURPOSES ONLY, INTENDED TO ENHANCE MARKETING VISUALS AND BETTER UNDERSTAND SPACE DESIGN

Client:

#Client E-mail
#Client Phone Number

LEGEND MAP:
HEATED COMMERC. FINISHED
HEATED RESIDENTIAL FINISHED
NOT HEATED/NOT FINISHED
COVERED PORCH
OPEN DECK

Revision History

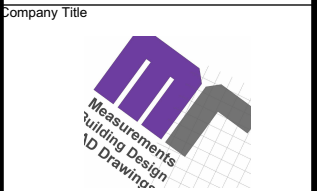


Company
Measure Rite LLC
103 Poplar Spring Trl. Hendersonville
Henderson County 28739

Site Address
**136 Senator Reynolds Rd,
Asheville, NC 28804**

Drawing Name
Generic Perspective / MAIN

Drawing Status
AS BUILT

Contact Name Alfred ZALYS mob. 828 231 7305	Job Nr. MR 1215 Date 8/9/2025
Drawing Scale 1/4" = 1'-0"	Layouts Total 5
Layout Nr.	Paper Size ANSI B
Layout ID AS BUILT-4	Revision

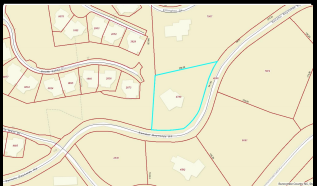

PROJECT LOCATION MAP

GENERAL NOTES:
1. DO NOT USE AS A BLUEPRINTS WITHOUT MR LLC PERMISSION.
2. PLEASE NOTE INTERIOR DIMENSIONS WERE NOT USED IN CALCULATING SQUARE FOOTAGE
3. SIZE OF HEATED AND NOT HEATED AREA AND OTHER INFORMATION WERE OBTAINED PER THE NC REAL ESTATE COMMISSION GUIDELINES (6" FOR EXTERNAL WALLS EXCEPT CONDOMINIUMS)
4. FOR REMODELING QUESTIONS OR MORE DETAILED CAD DRAWINGS (INC.SITE PLAN, SECTIONS, ELEVATIONS) ALSO 3D MODEL PLEASE CONTACT ALFRED ZALYS
MOB. 828 231 7305 E-MAIL: A.ZALYS@HOTMAIL.COM
5. THE FURNITURE SHOWN IS FOR ILLUSTRATIVE PURPOSES ONLY, INTENDED TO ENHANCE MARKETING VISUALS AND BETTER UNDERSTAND SPACE DESIGN


Client:

#Client E-mail
#Client Phone Number

LEGEND MAP:
HEATED COMMERC. FINISHED
HEATED RESIDENTIAL FINISHED
NOT HEATED/NOT FINISHED
COVERED PORCH
OPEN DECK

Revision History

Company Title

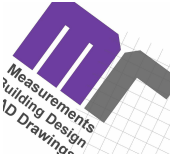


Company
Measure Rite LLC
103 Poplar Spring Trl. Hendersonville
Henderson County 28739

Site Address
**136 Senator Reynolds Rd,
Asheville, NC 28804**


Drawing Name
Generic Perspective / LOWER

Drawing Status
AS BUILT

Contact Name Alfred ZALYS mob. 828 231 7305	Job Nr. MR 1215 Date 8/9/2025
Drawing Scale 1/4" = 1'-0"	Layouts Total 5
Layout Nr. 5	Paper Size ANSI B
Layout ID AS BUILT-5	Revision

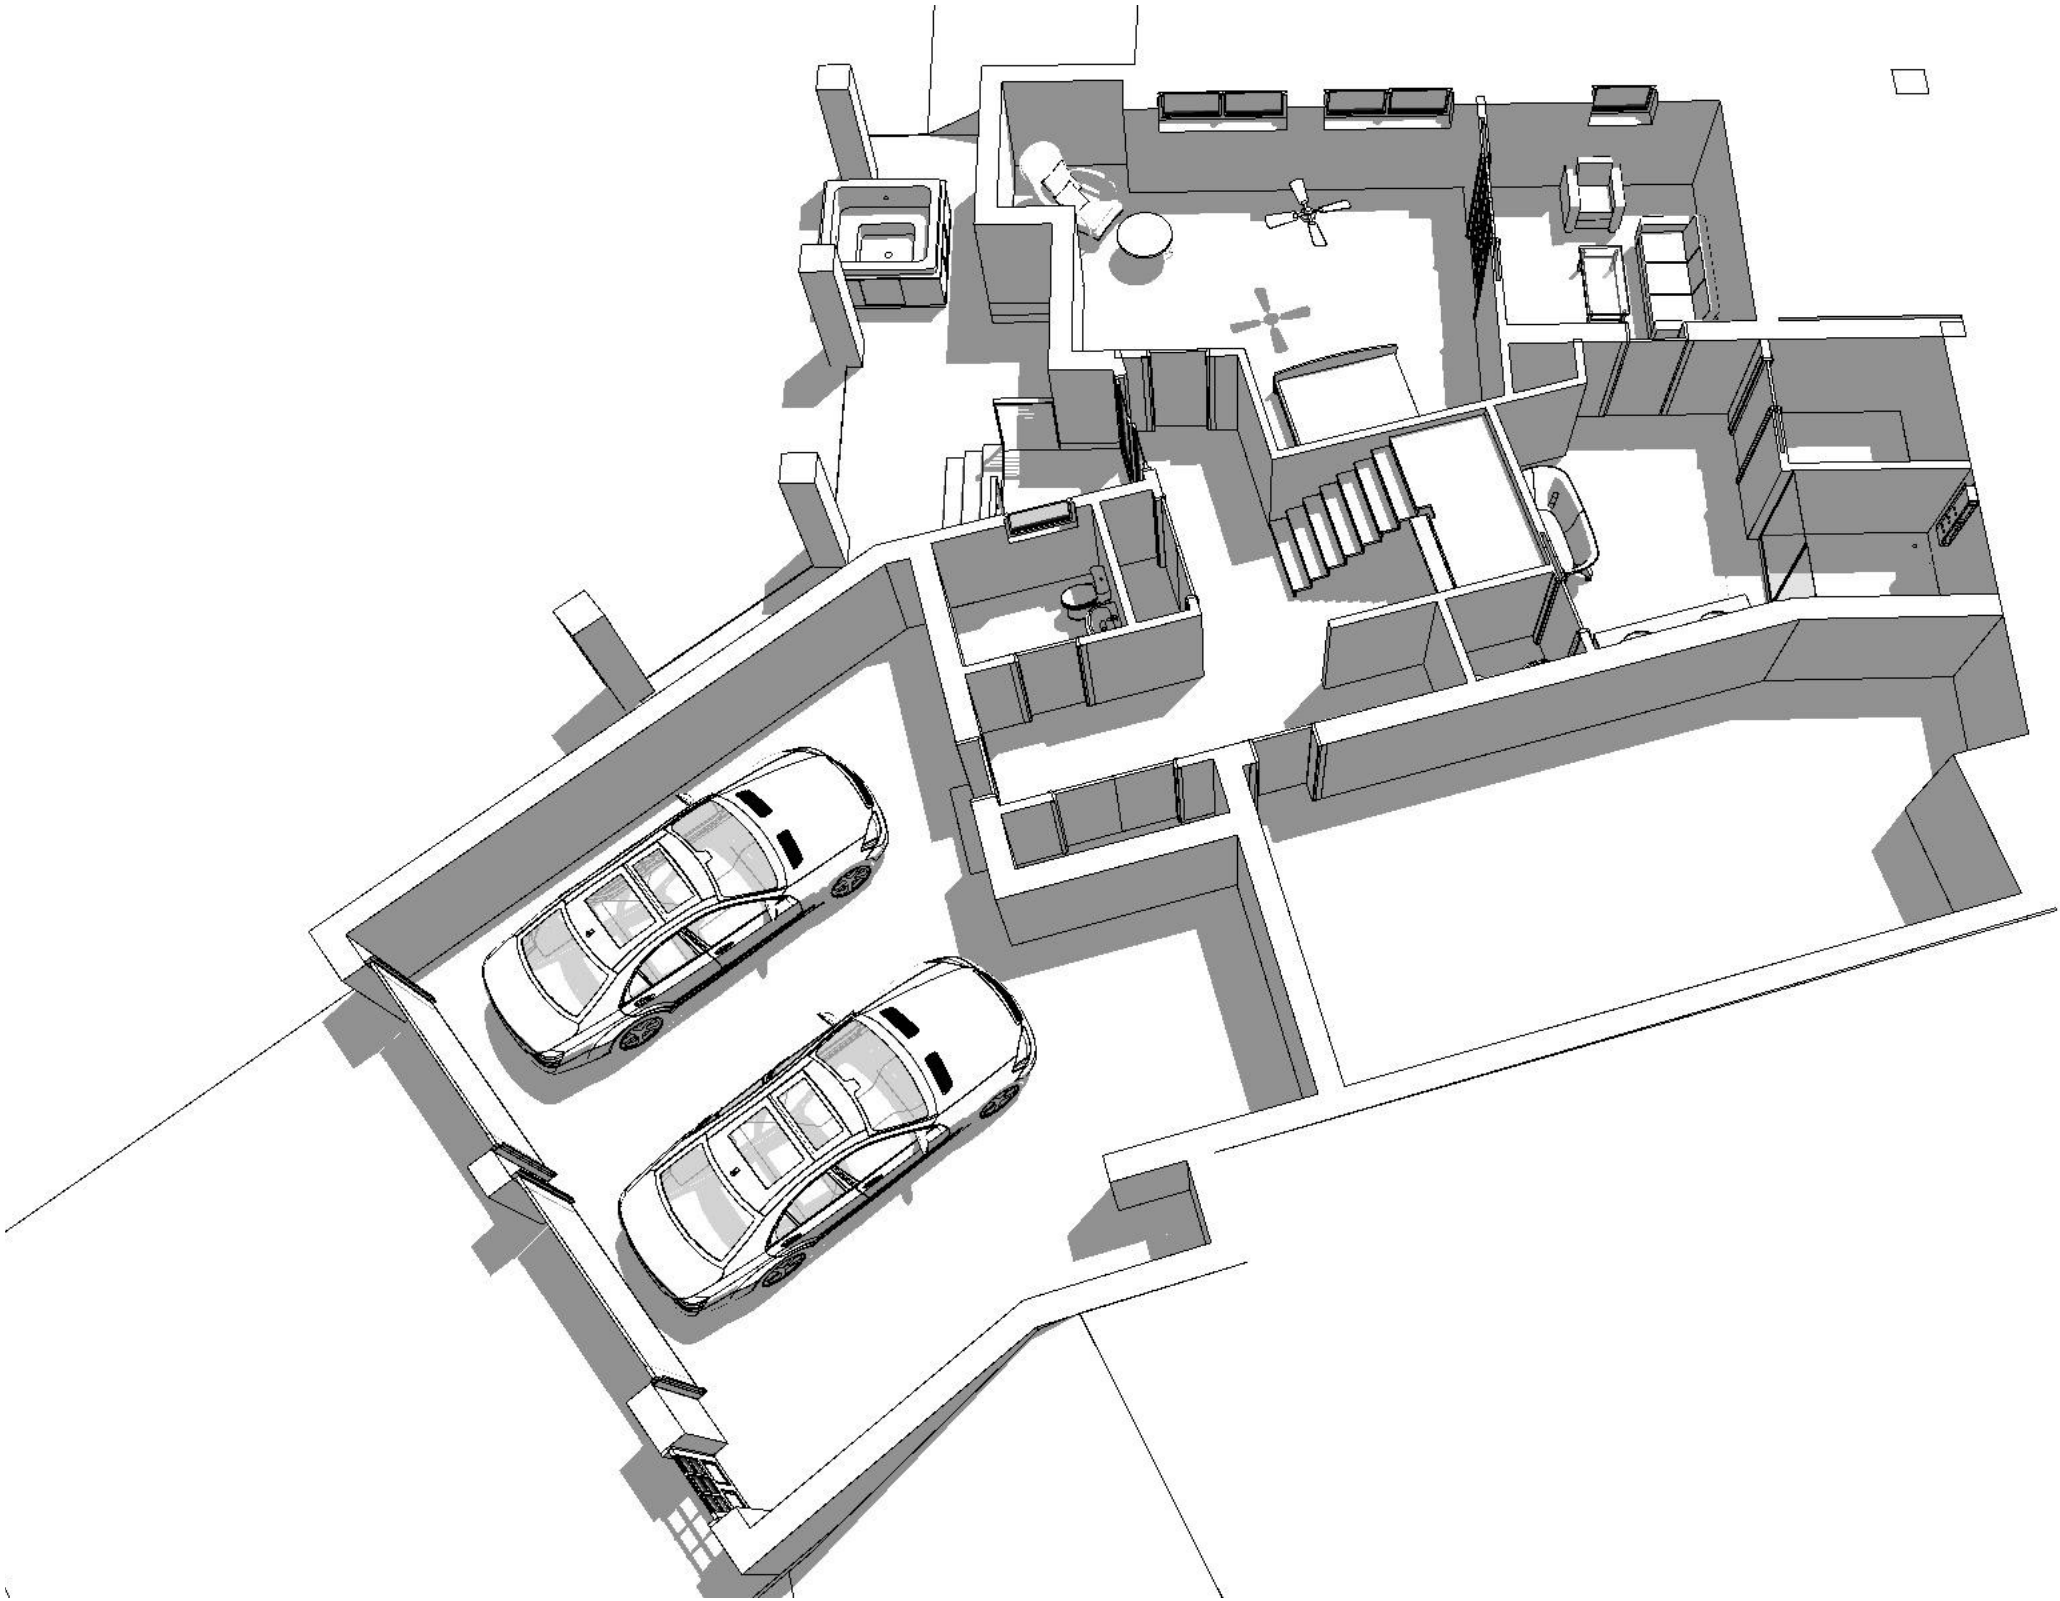

Generic Perspective / LOWER

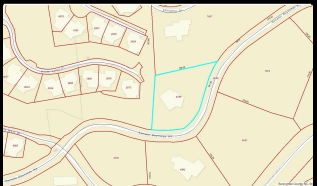

PROJECT LOCATION MAP

- GENERAL NOTES:
- 1. DO NOT USE AS A BLUEPRINTS WITHOUT MR LLC PERMISSION.
 - 2. PLEASE NOTE INTERIOR DIMENSIONS WERE NOT USED IN CALCULATING SQUARE FOOTAGE
 - 3. SIZE OF HEATED AND NOT HEATED AREA AND OTHER INFORMATION WERE OBTAINED PER THE NC REAL ESTATE COMMISSION GUIDELINES (6" FOR EXTERNAL WALLS EXCEPT CONDOMINIUMS)
 - 4. FOR REMODELING QUESTIONS OR MORE DETAILED CAD DRAWINGS (INC.SITE PLAN, SECTIONS, ELEVATIONS) ALSO 3D MODEL PLEASE CONTACT ALFRED ZALYS MOB. 828 231 7305 E-MAIL: A.ZALYS@HOTMAIL.COM
 - 5. THE FURNITURE SHOWN IS FOR ILLUSTRATIVE PURPOSES ONLY, INTENDED TO ENHANCE MARKETING VISUALS AND BETTER UNDERSTAND SPACE DESIGN

Client:


#Client E-mail
#Client Phone Number

LEGEND MAP:

- HEATED COMMERC. FINISHED
- HEATED RESIDENTIAL FINISHED
- NOT HEATED/NOT FINISHED
- COVERED PORCH
- OPEN DECK

Revision History

Company Title

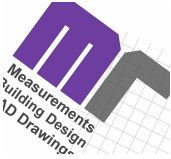

Company

Measure Rite LLC
103 Poplar Spring Trl. Hendersonville
Henderson County 28739

Site Address

**136 Senator Reynolds Rd,
Asheville, NC 28804**

Drawing Name

Generic Perspective /UPPER

Drawing Status

AS BUILT

Contact Name

Alfred ZALYS
mob. 828 231 7305

Job Nr.

MR 1215

Date

8/9/2025

Drawing Scale

1/8" = 1'-0"

Layouts Total

5

Layout Nr.

5


Paper Size

ANSI B

Layout ID

AS BUILT-6

Revision

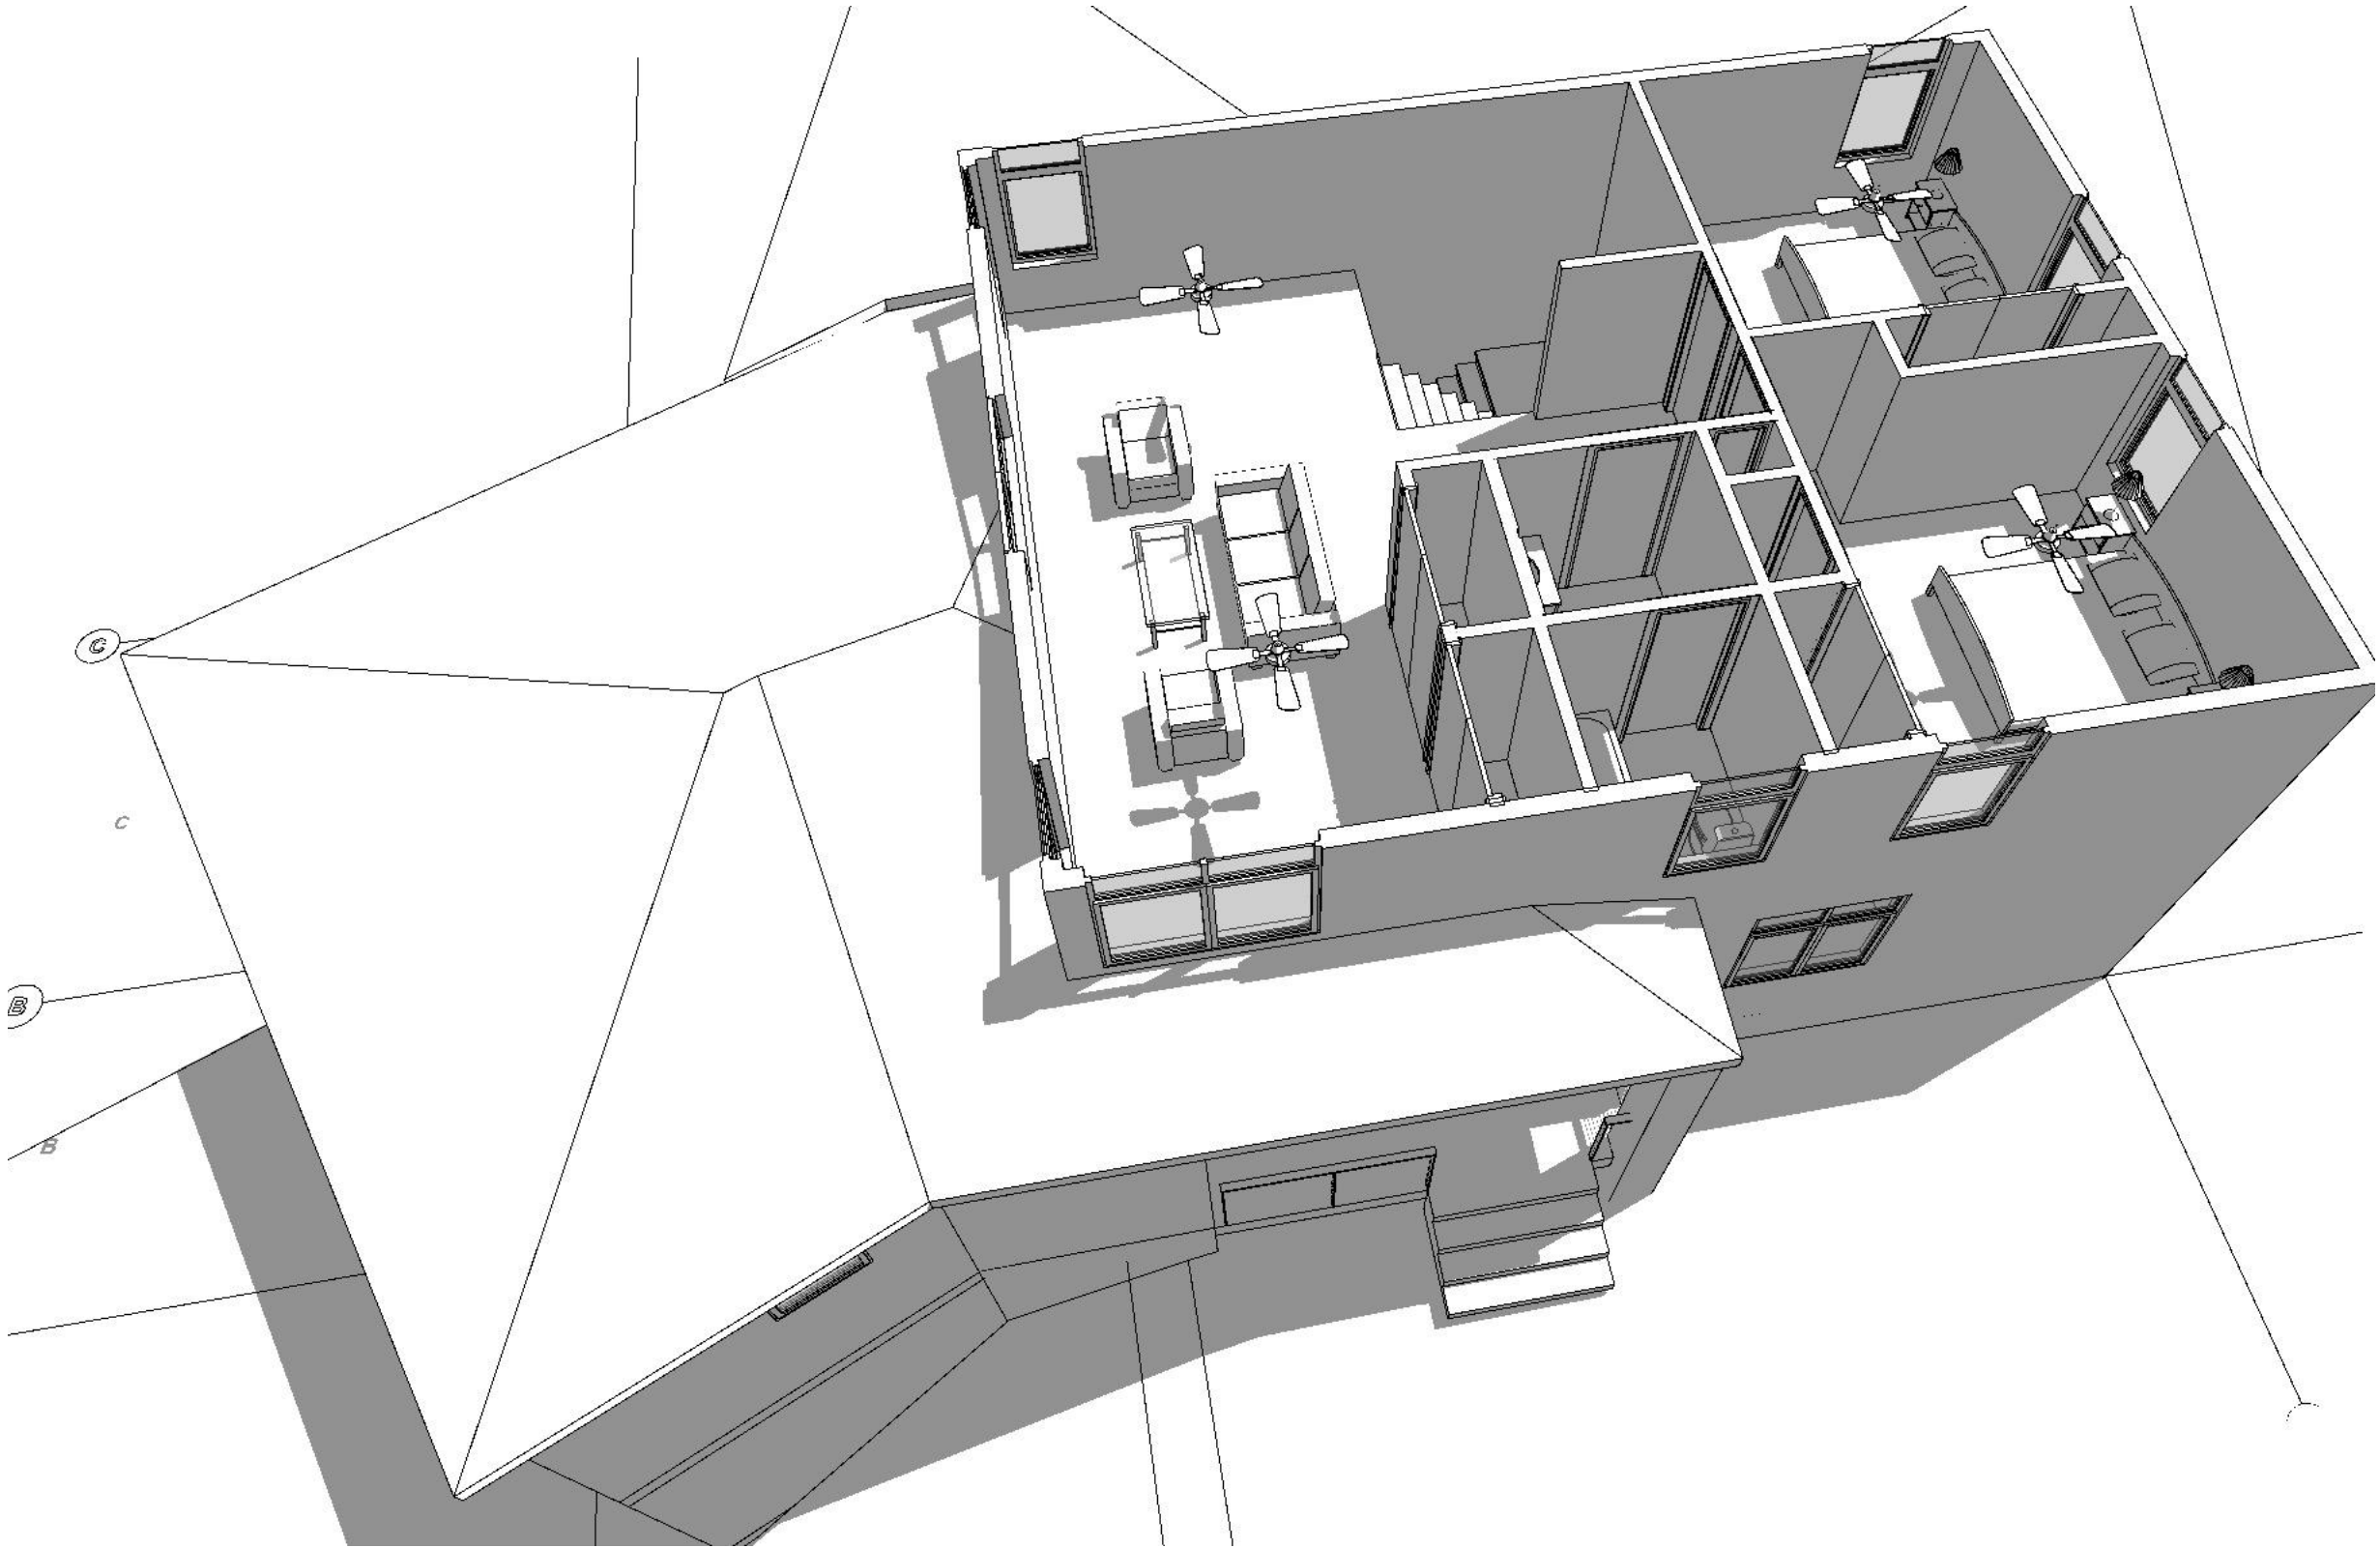

Generic Perspective /UPPER