


RECEIVED

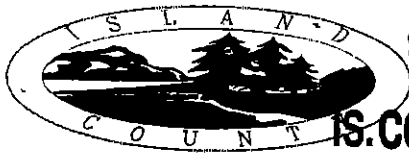

SEP 11 2009 Receipt # 187910

As Built# PT2009-354

Partial Asbuilt

IS. CO. HEALTH DEPT.

Health Department
PO Box 5000 Coupeville WA 98292

PERMIT TO CONSTRUCT A SEWAGE DISPOSAL SYSTEM

Applicant Name: Alex Clark Phone #: 206-818-0781

Owner Name:

Mailing Address: P O Box 21724, Seattle, WA 98111

Tax Parcel Number: S8195-00-00013-0 Twp: Rge: Sec:

Off-site Drainfield Parcel Number (if applicable):

Address of Construction Site: 3086 Spahr Road

Property Length: 210-220'+/- Property Width: 180'+/- Area: .9ac +/-

Name of Water System: Spahr View Water Assoc Private Well ☐

Are there any critical areas within 100 feet of the project? ☒ No Yes ☐ (attach report)

Are there any bluffs or banks within 100 feet of the project? ☒ No Yes ☐ (attach report)

Is property in an archeologically significant area? ☒ No Yes ☐ (attach report)

Is property within 800 feet of protected species area or on the shore? ☒ No Yes ☐ (attach report)

Is property designated open agriculture/space/timber or designated forest? ☒ No Yes ☐

Type of Use: Residential: ☒ Restaurant ☐ Other: (attach narrative)

Number of Bedrooms: Two Projected Gallons per day: 300

Soil Type: IV (.48) Site Registration * SR03-142N, SR06-334

Drainfield Size: 652 sq feet Length: 49 ft Width: 25 ft

Trench Depth: N/A in Septic Tank Size: 1000 gal Pump Chamber Size: 1000 gal

Designer Comments:

Two bedroom home served by a Glendon Biofilter. Critical area report on file with county. Redesign of 326-08

Health Department Comments:

- ① see attached "Glendon Box" engineering
- ② Dry Season install only
- ③ Grade tank area to protect tanks from groundwater
- ④ see attached WAVE

We understand that changes to this site such as grading, filling or clearing, or any deviation from the original plan (as depicted on back) such as, but not limited to: (a) dwelling location, (b) placement of wells, drainfields, curtain drains, tanks, etc. without first receiving approval from the Island County Health Department, automatically voids this permit.

Owner Signature: Date: 9/11/09

Designer's / Agents Signature: Date: Sept 10, 2009

This permit is issued with the understanding that the property owner will allow, at the request of the Health Department representative to enter onto this property during reasonable hours, for the sole purpose of monitoring the performance of the sewage disposal system.

A permit to construct a sewage disposal system shall be valid for three years from the date of issuance. Permits are transferable with property ownership provided the new owners accept the permitted plan. If the system is not installed within three years, a new permit may be applied for based on current standards and requirements.

For Health Department Use Only (version 5/03)

System Type: Conventional ☐ Alternative ☒ Commercial / community ☐

Water Approved? No ☐ Yes ☒ By: Restrictive Covenant: No ☒ Yes ☐ AF#

Drainfield Easement: No ☒ Yes ☐ AF# O&M Required: No ☐ Yes ☒ annually

Plan Approved ☒ Plan Disapproved ☐ Date: 9/25/09

Permit Number: PT2009-354 Expiration Date: 7/21/11

System Installed by: Karl Hjorten Construction inspection date(s): 8/24/2023


Final Inspection: Approved: N/A Rejected: Date: N/A

As-Built Approval: Approved: MB Rejected: Date: 8/7/2023

Not within a bald eagle habitat area: ☒

Partial Asbuilt

182

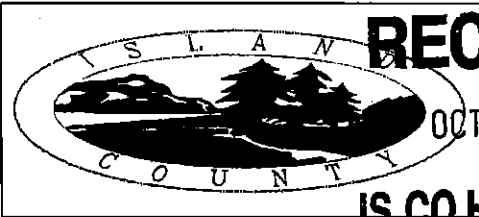

RECEIVED

OCT 28 2009

IS CO HEALTHDEPT.

Property Owner: Alex Clark

As-Built# PT2009-354

Island County Health Department

PO Box 5000 Coupeville WA 98239

Parcel # S8195-00-00013-0


Septic System As-Built Version 5/03

Partial Asbuilt

Provide Accurate Plot Plan to Scale including, but not Limited to:

Drainfields, wells, tanks, banks, buildings, roads, utilities, easements, property lines, critical areas, etc.

Scale 1 inch = 30 ft

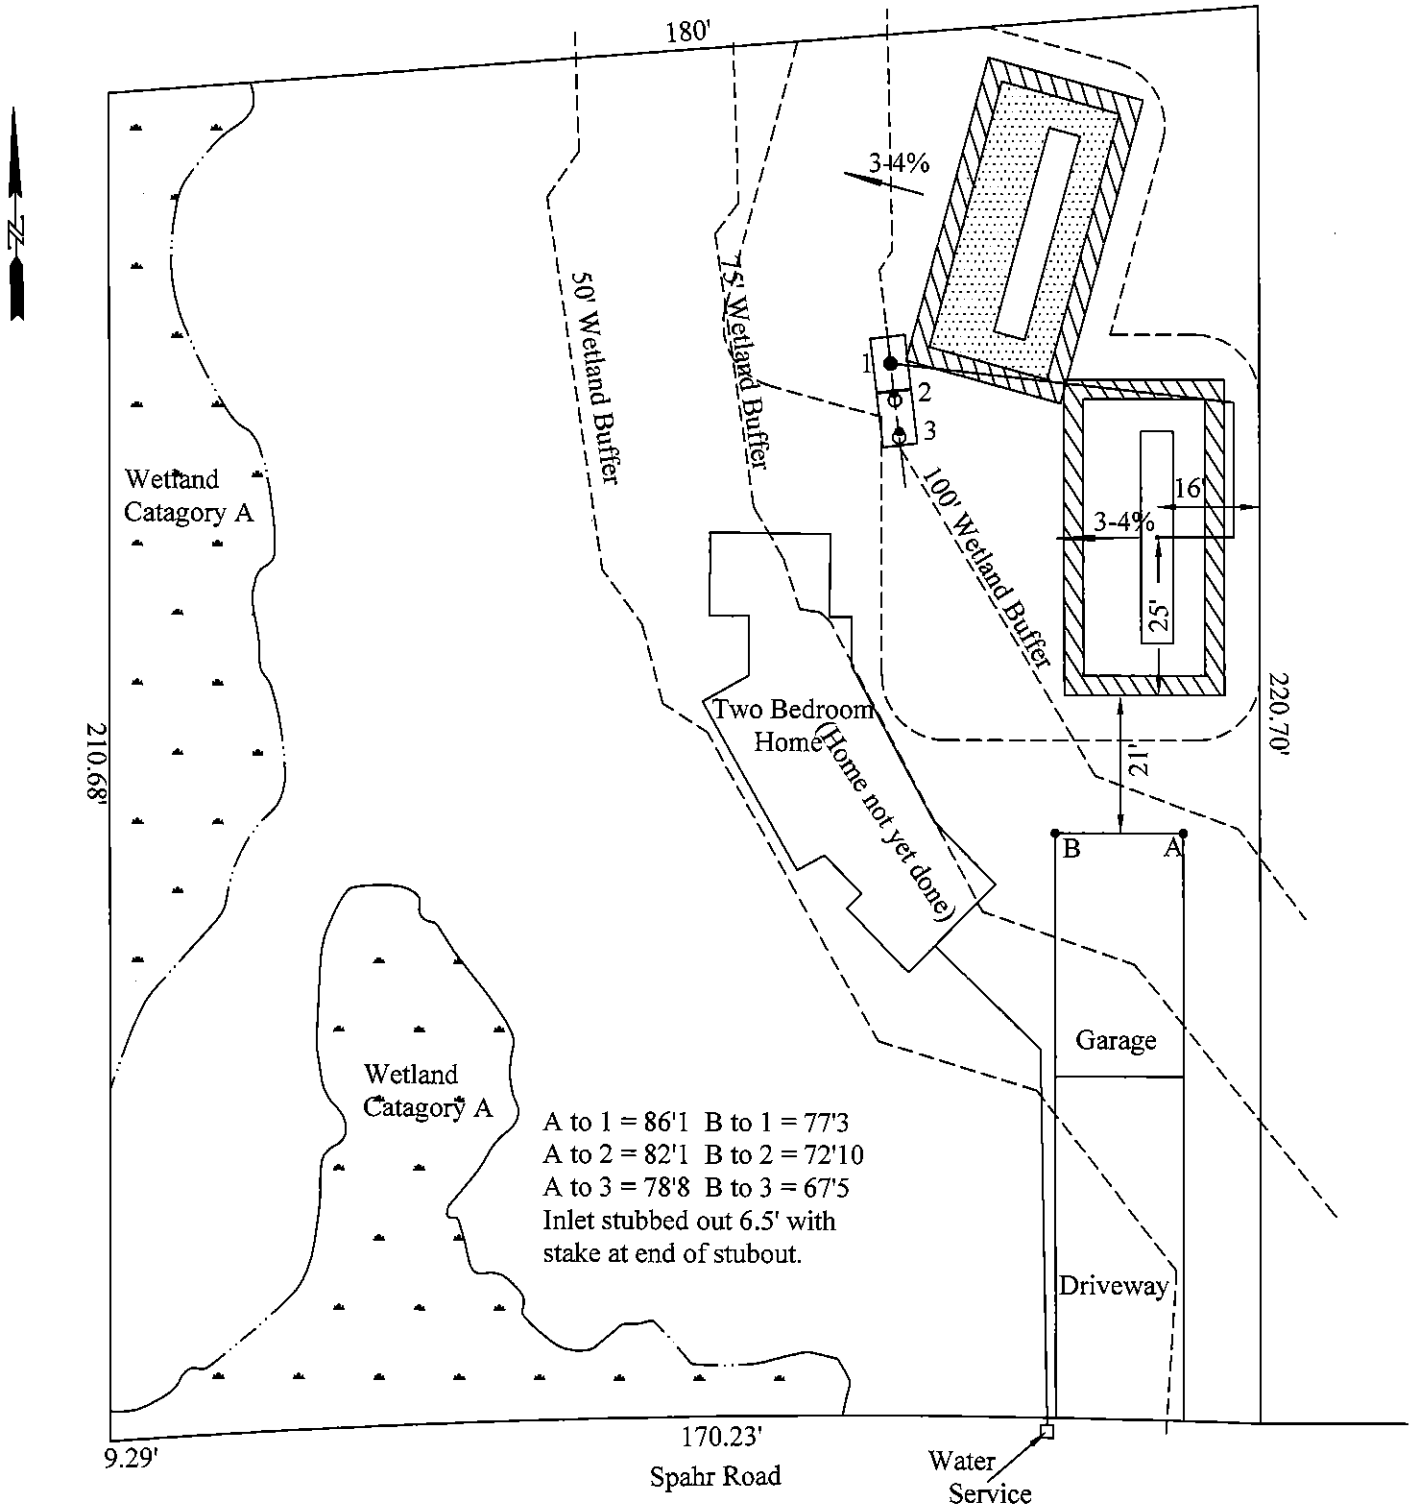

AB Lead Pump Info

Time Dosed: ☒ yes ☐ no

Pump Model: 1/3 HP Hydro

Run Time: Proprietary

Off Time: Proprietary

Volume: Proprietary

Glendon Information

Basal Area: 652 sf

Final Dimension: 25' x 49'

Tank Information

Manufacturer: Krieg

Septic Tank Size: 1000 gal

Pump Tank Size: 1000 gal

Comments:

I, the undersigned, personally inspected this On-site Sewage Disposal system and certify that it was installed in accordance with the approved design, including all requirements deemed necessary by all proprietary devices and this system fully complies with all conditions of I.C.C 8.07.

Partial Asbuilt

Installers Signature:

Date Installed: Sept 24, 2009

282